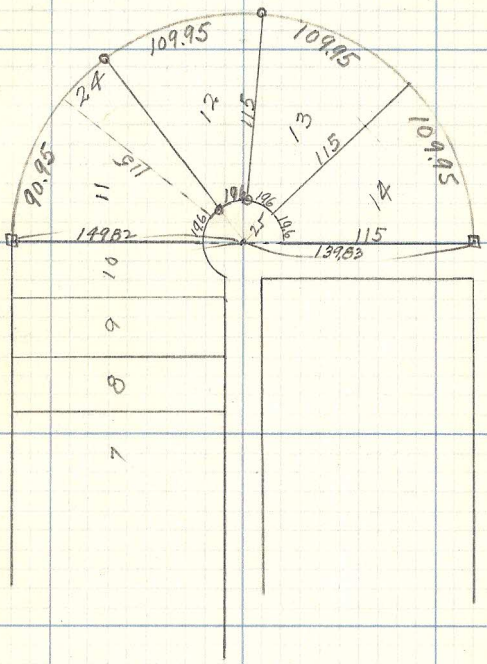

Lot 12 Warrendale Blk. 5