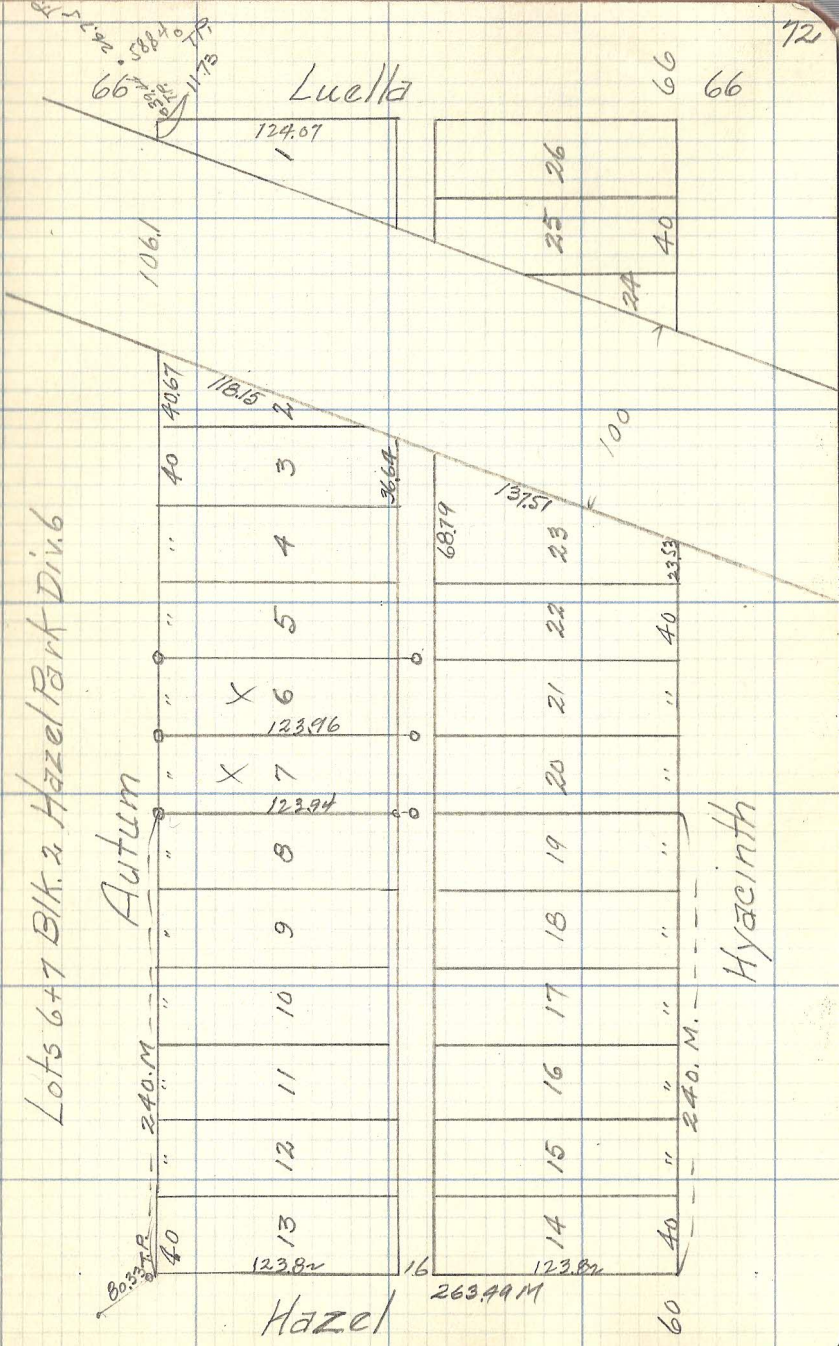
Lots 6+7 Blk. 2 Hazel Park Div. 6
Luella
Autum
Hyacinth
Hazel
66
66
66
124.07
106.1
118.15
40.67
36.64
137.51
68.79
23.53
123.96
123.94
240.M
240.M.
123.82
123.82
263.49 M
80.33 T.P.
100
16
60
1
2
3
4
5
6
7
8
9
10
11
12
13
14
15
16
17
18
19
20
21
22
23
24
25
26
40