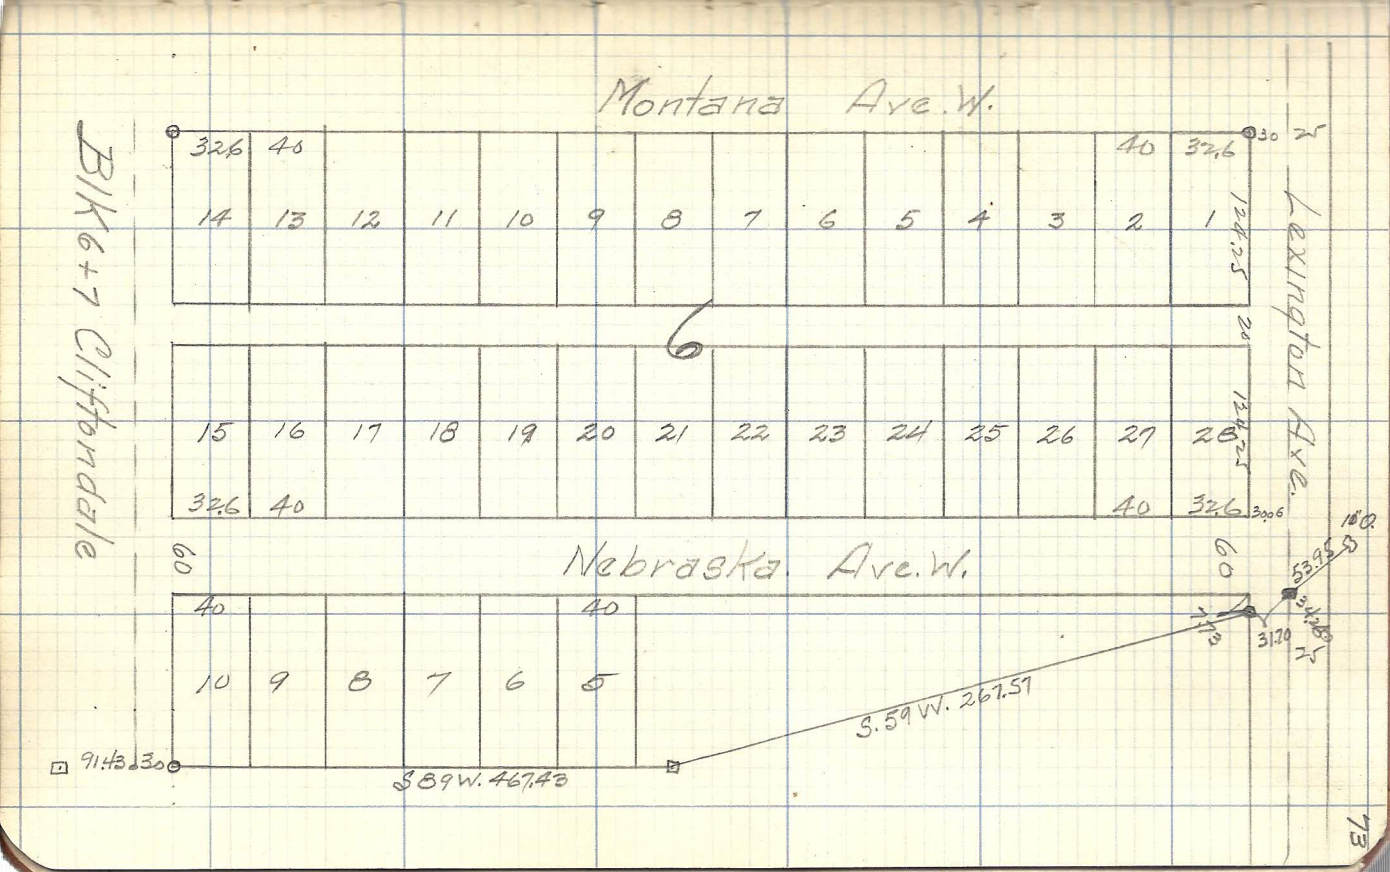
Montana Ave. W.
Lexington Ave.
Nebraska. Ave. W.
Blk 6 + 7 Cliffsdale
6
14 13 12 11 10 9 8 7 6 5 4 3 2 1
15 16 17 18 19 20 21 22 23 24 25 26 27 28
10 9 8 7 6 5
32.6 40 40 32.6
124.25
60
S.89 W. 467.43
S.59 W. 267.57
91.43.30
53.95
31.20
180