


Also in Book 3 page 6

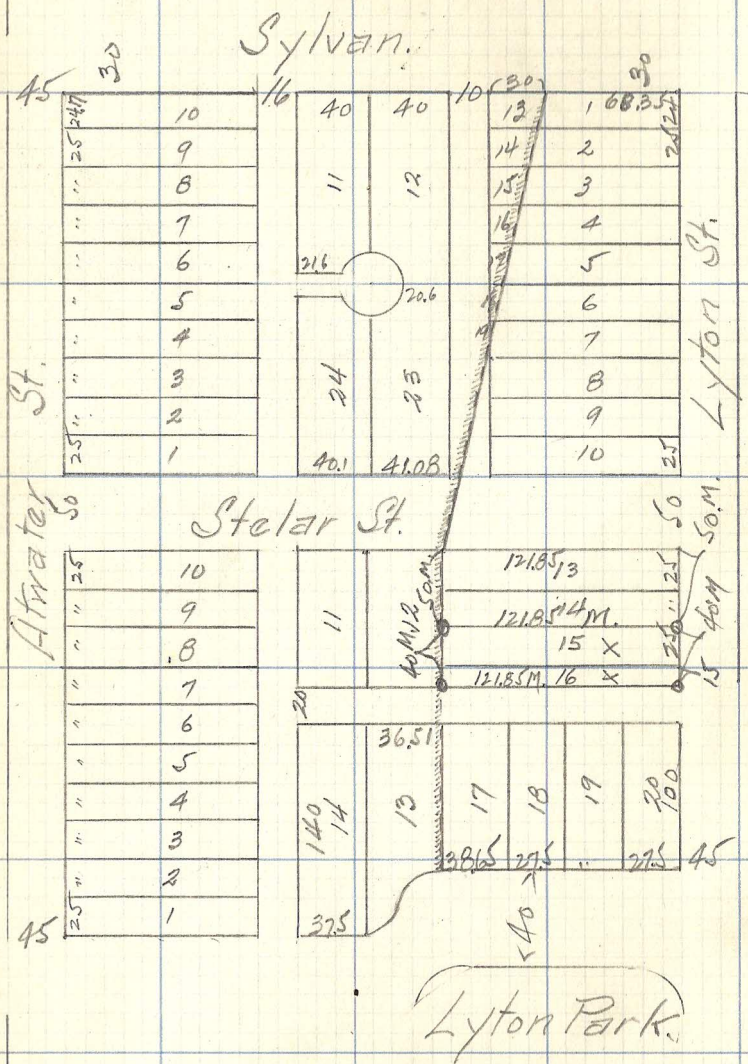

Lot 15+16 BIKI
Lyton's Add.