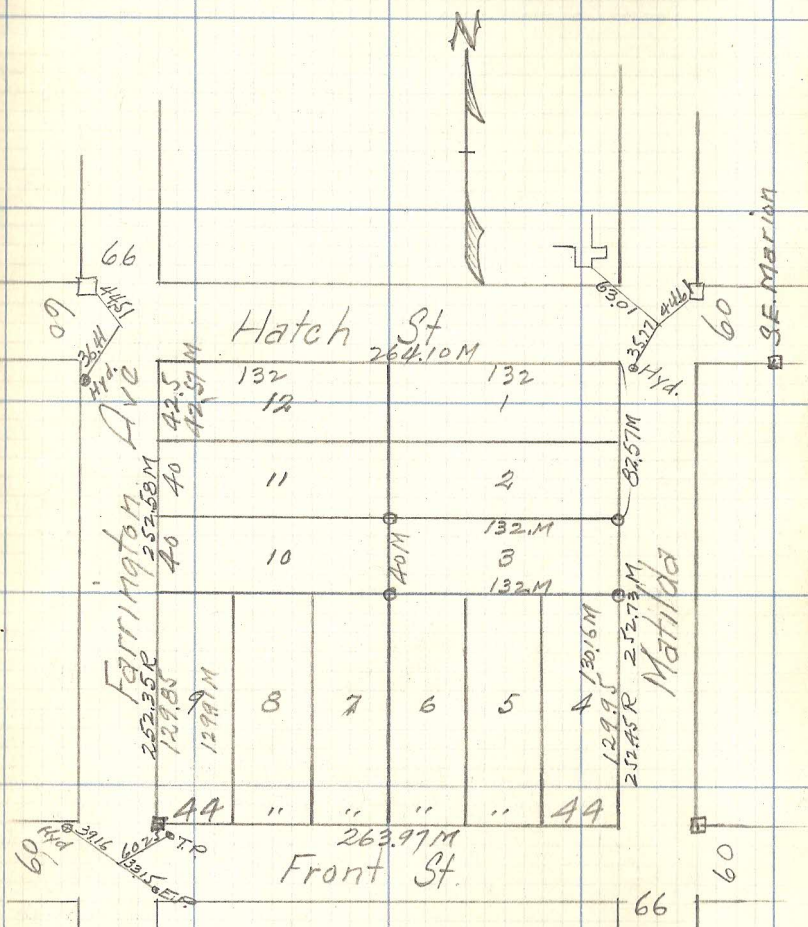

Lot 3 Blk 48

Auerbach & Hands Add.