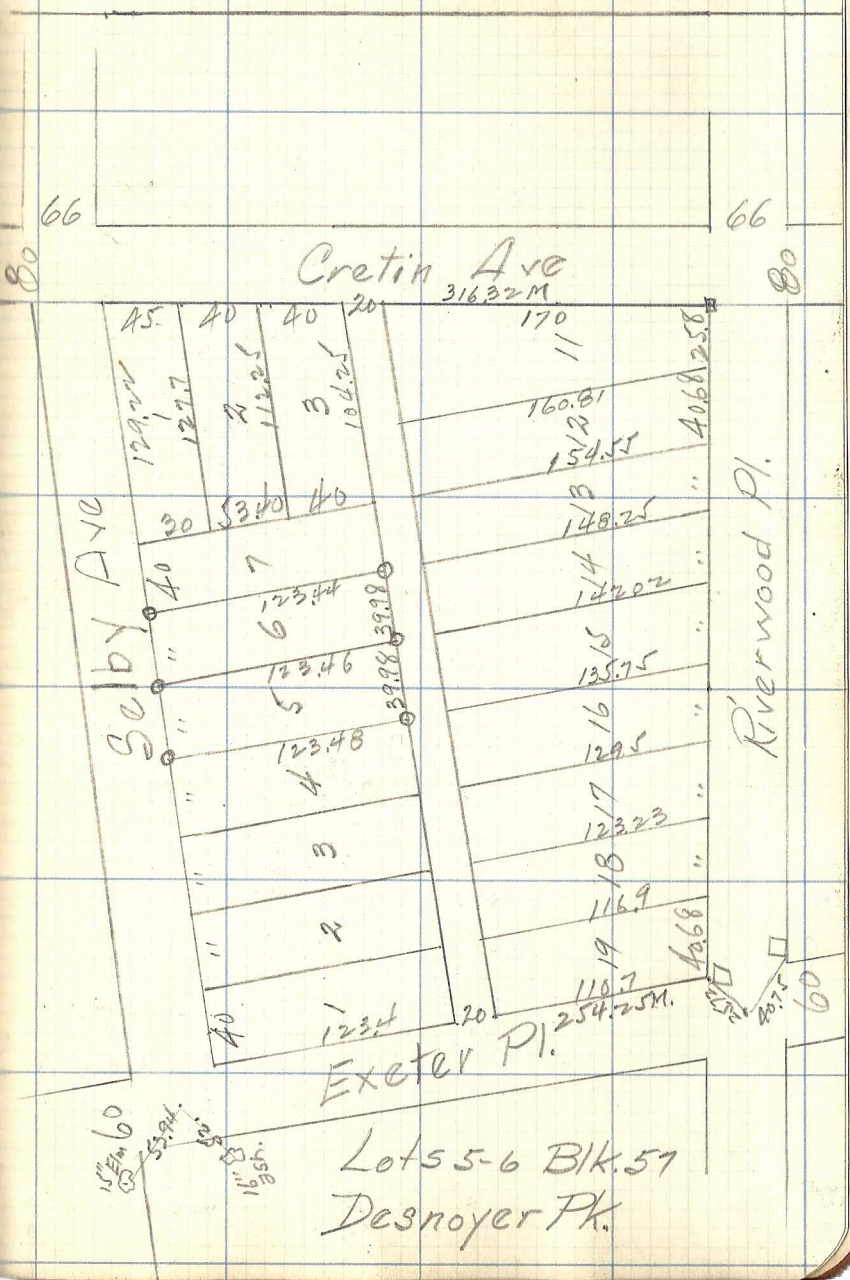
66
66
80
80
Cretin Ave
316.32M
170
45.
40
40
20
129.2
127.7
142.2
164.2
30
53.40
40
40
7
6
5
4
3
2
1
123.44
123.46
123.48
123.4
39.98
39.98
20
160.81
154.5
148.2
142.02
135.75
129.5
123.23
116.9
110.7
254.25M.
406.25
406.6
40.75
Selby Ave
Riverwood Pl.
Exeter Pl.
60
60
15" Elm
53.94
16" Elm
Lots 5-6 Blk. 57
Desnoyer Pk.