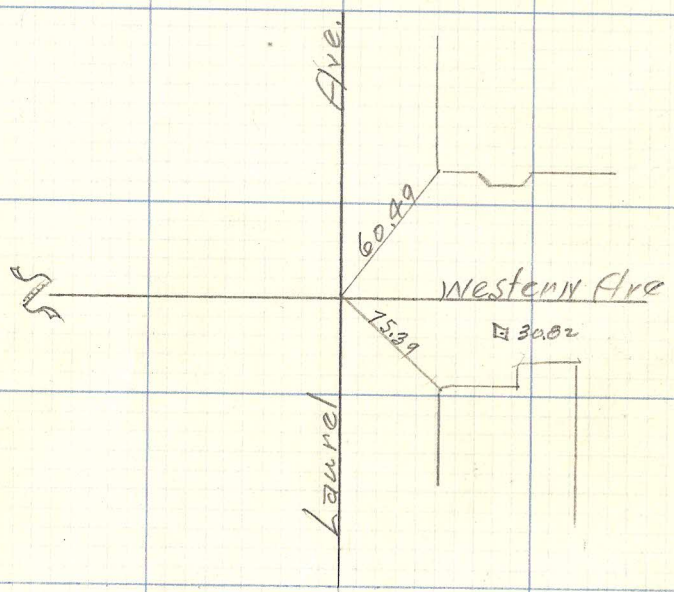
Laurel Ave.
Western Ave
60.49
75.39
30.82

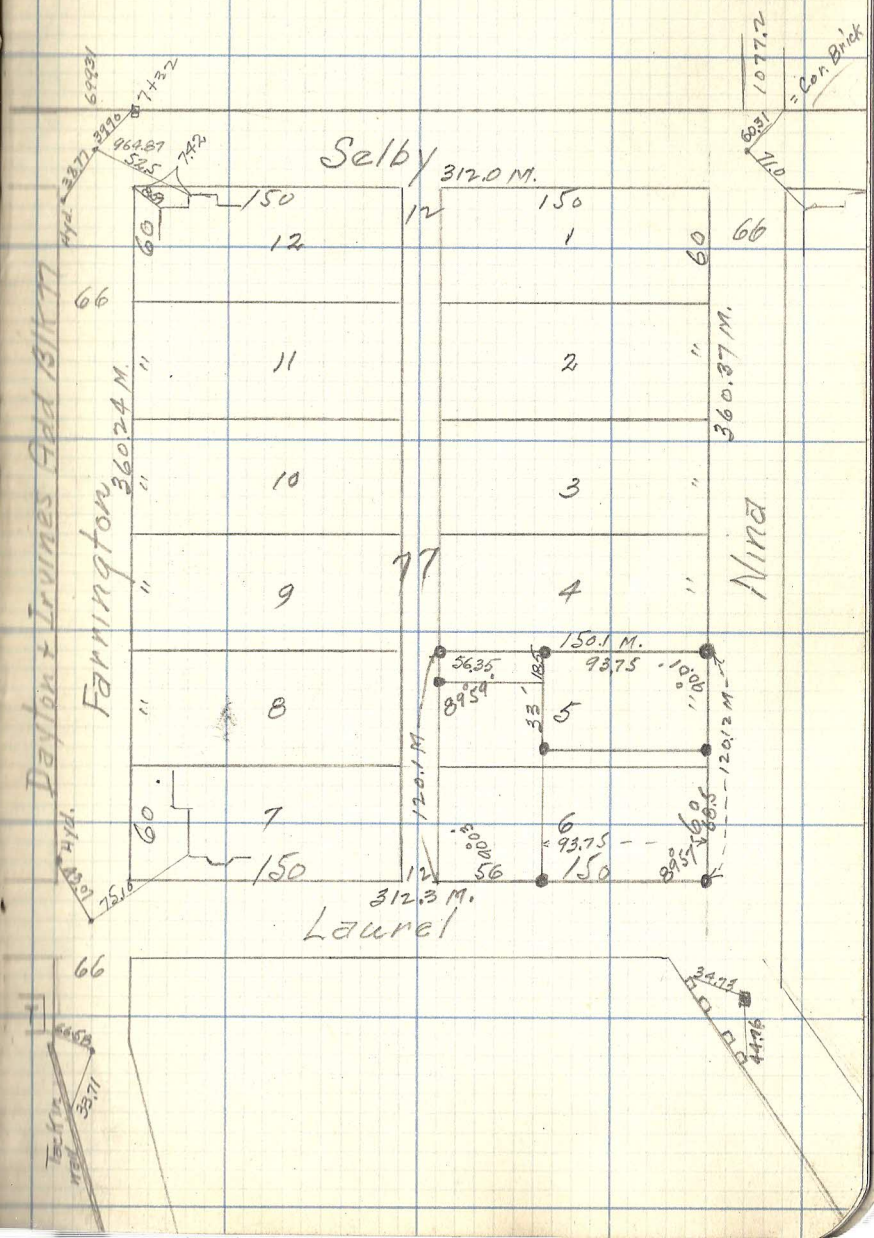
Selby
312.0 M.
Farrington
360.24 M.
Nina
360.37 M.
Laurel
312.3 M.
Dayton + Irvines Add Blk 77
150
12
11
10
9
8
7
1
2
3
4
5
6
77
150.1 M.
93.75
56.35
120.1 M.
120.12 M.
66
60
Hyd.
Tack Wd.
Cor. Brick
1077.2
60.31
71.0
34.73
44.76
33.71
75.10