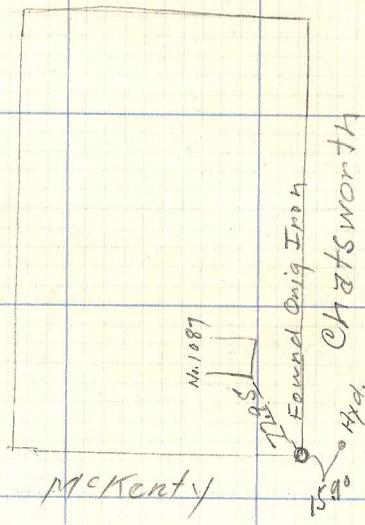
Chatsworth
Found Orig Iron
No. 1087
Hyd.
McKenty
159.0

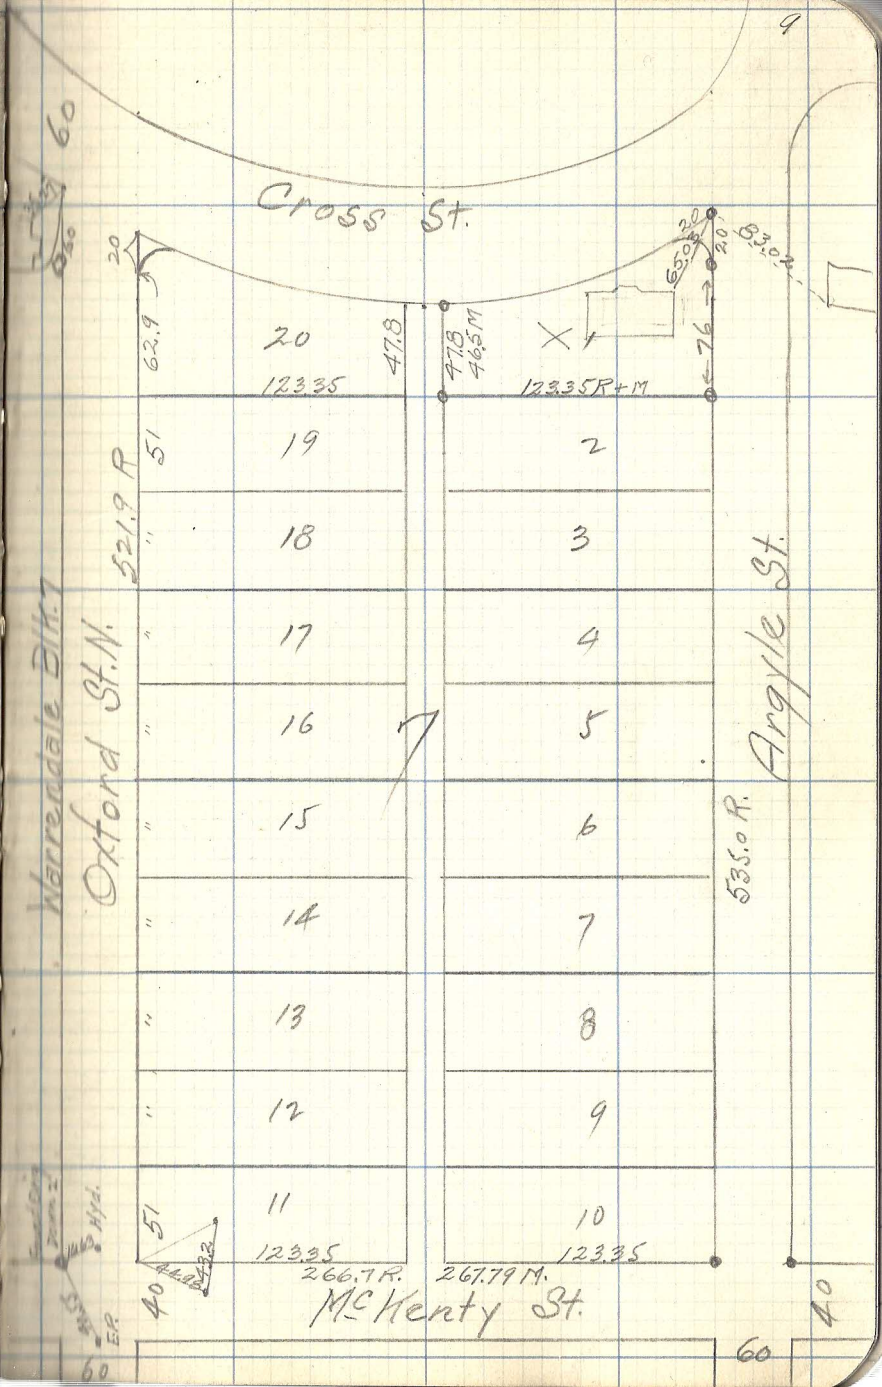
Cross St.
Warrendale Blk. 7
Oxford St. N.
Argyle St.
McKenty St.
521.9 R
535.0 R.
20
19
18
17
16
15
14
13
12
11
2
3
4
5
6
7
8
9
10
123.35
123.35 R+M
266.7 R.
267.79 M.
62.9
47.8
47.8
46.5 M
76
51
40
60
Hyd.
E.P.