East 1/2 of Lot 9 Blk 10

Elfelt. Bernheimer & Arnolds Add.
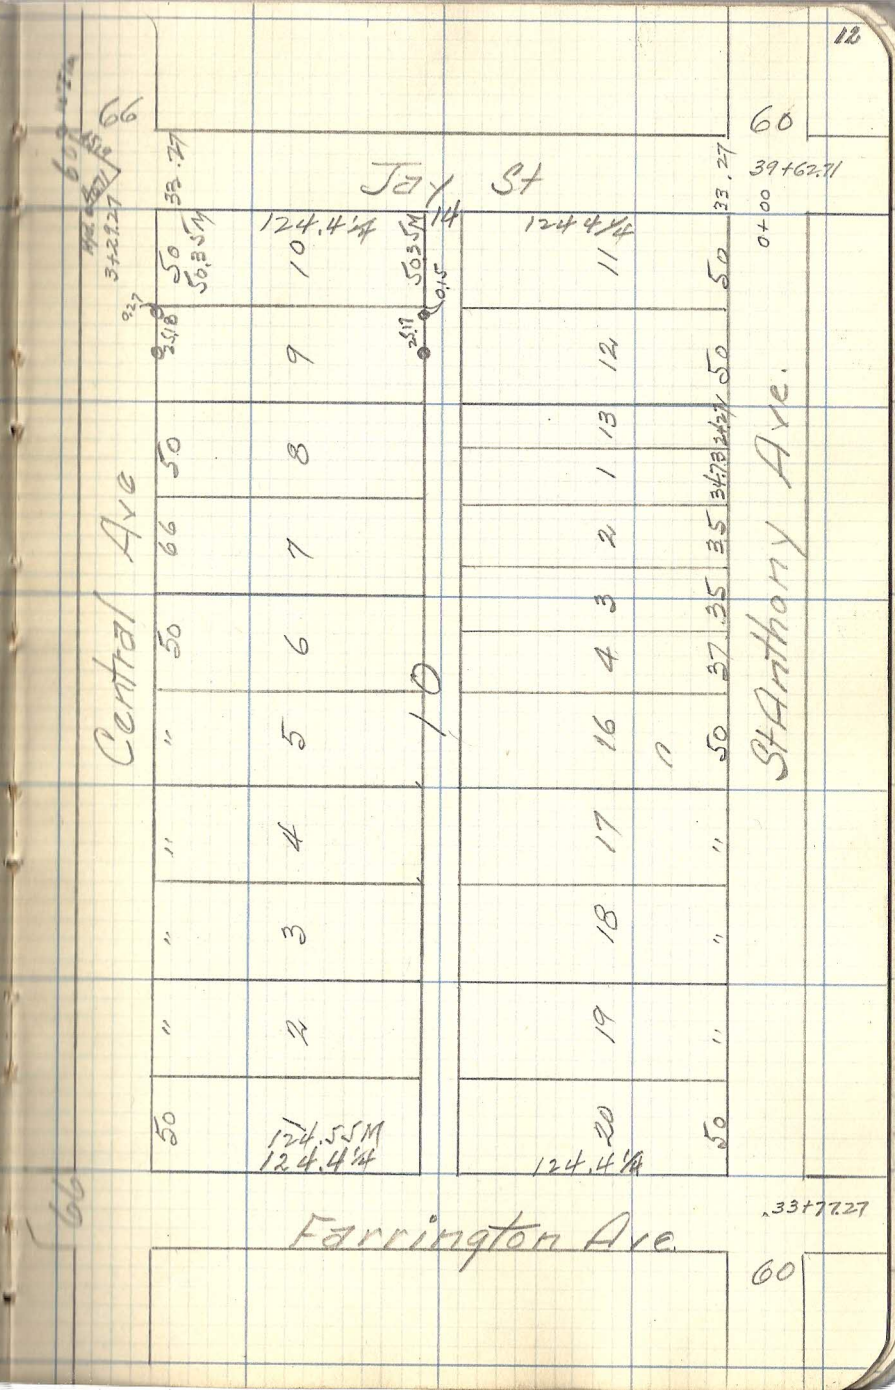
Location of Eaves & Gutter
on page 22