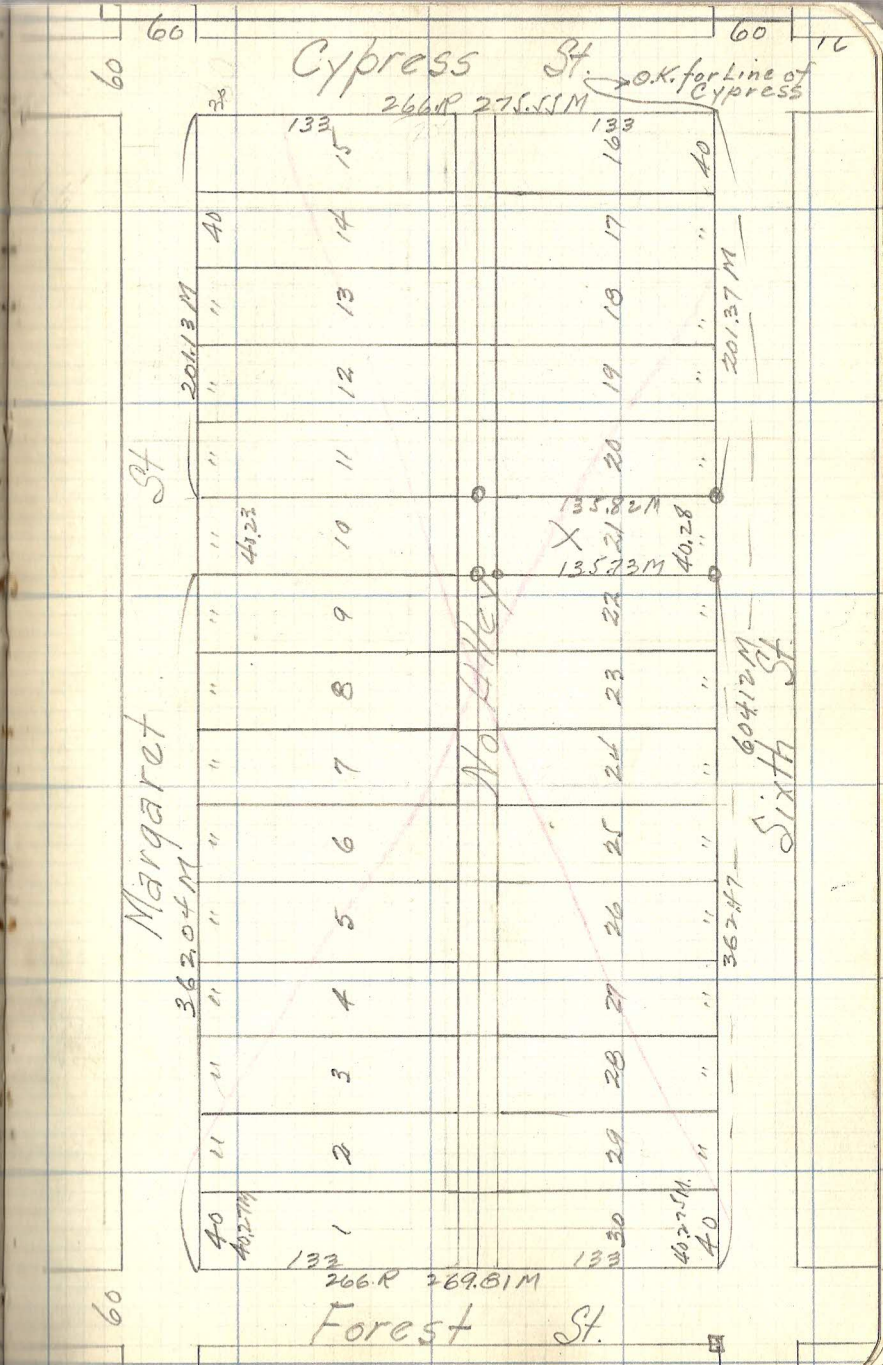Lot 21 Blk 102
H.M. Ranney's Sub of Blk 102
Lyman-Dayton's Add.