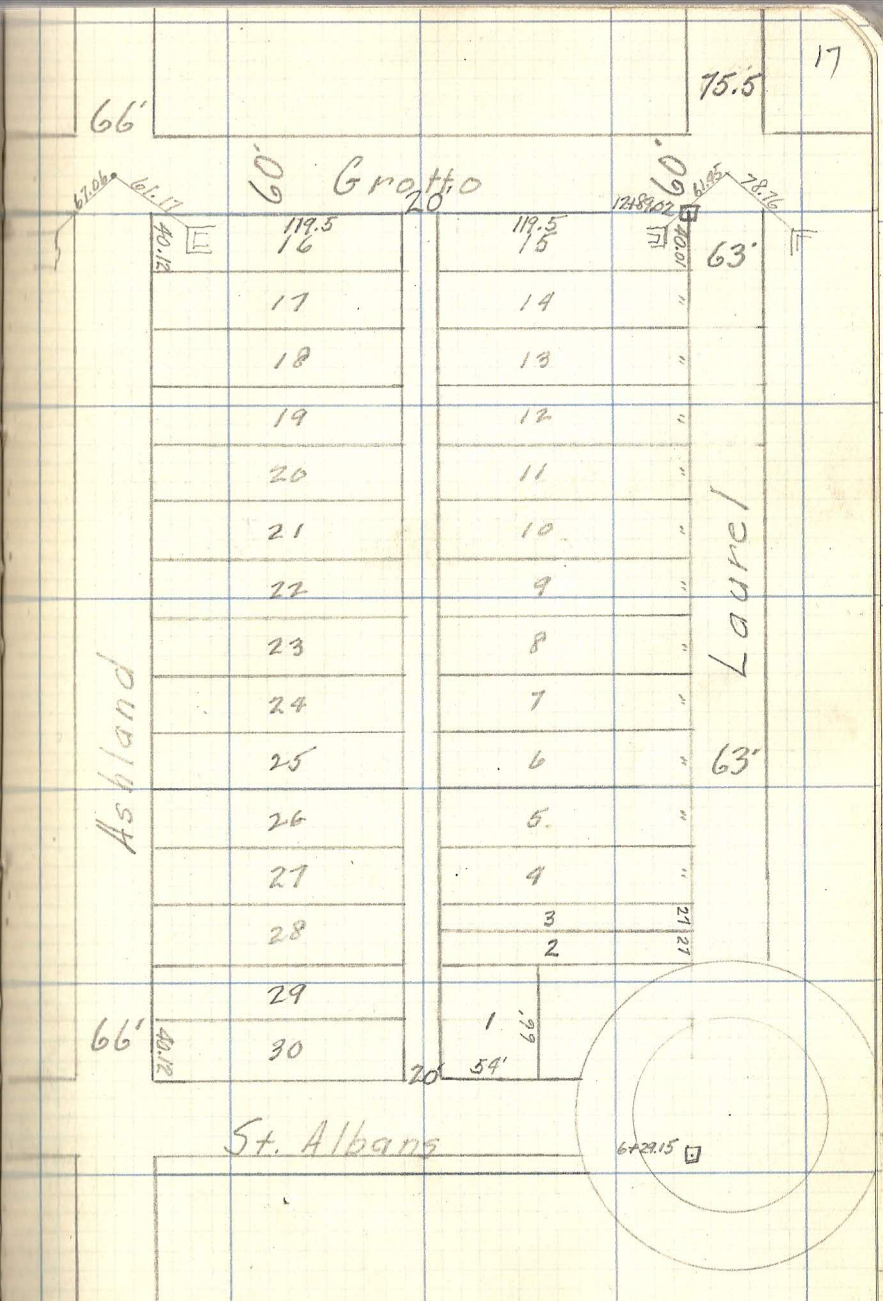Lot 16 BIK 10
Holcomb's Add