


Prior Ave	
125	125
15	15
16	13
17	12
18	11
19	10
20	9
21	8
22	7
23	6
24	5
25	4
26	3
27	2
28	1
Kenneth.	
18	19
17	20
16	21
15	22
14	23
13	24
12	25
11	26
10	27
9	28
8	29
7	30
45	45
5	5
4	4
3	3
2	2
1	1

St. Catherines Manor.

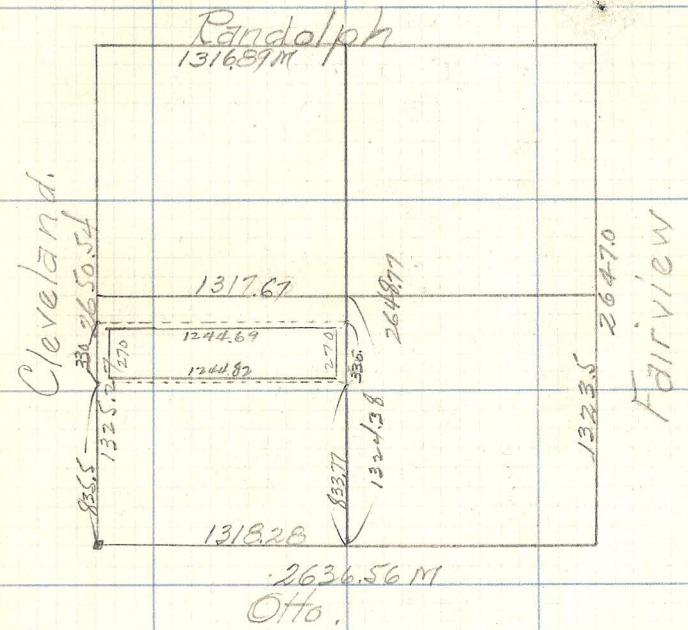

Cleveland Ave.