


Phalen Driveway Paved

Jan. 8-1924
R.H.

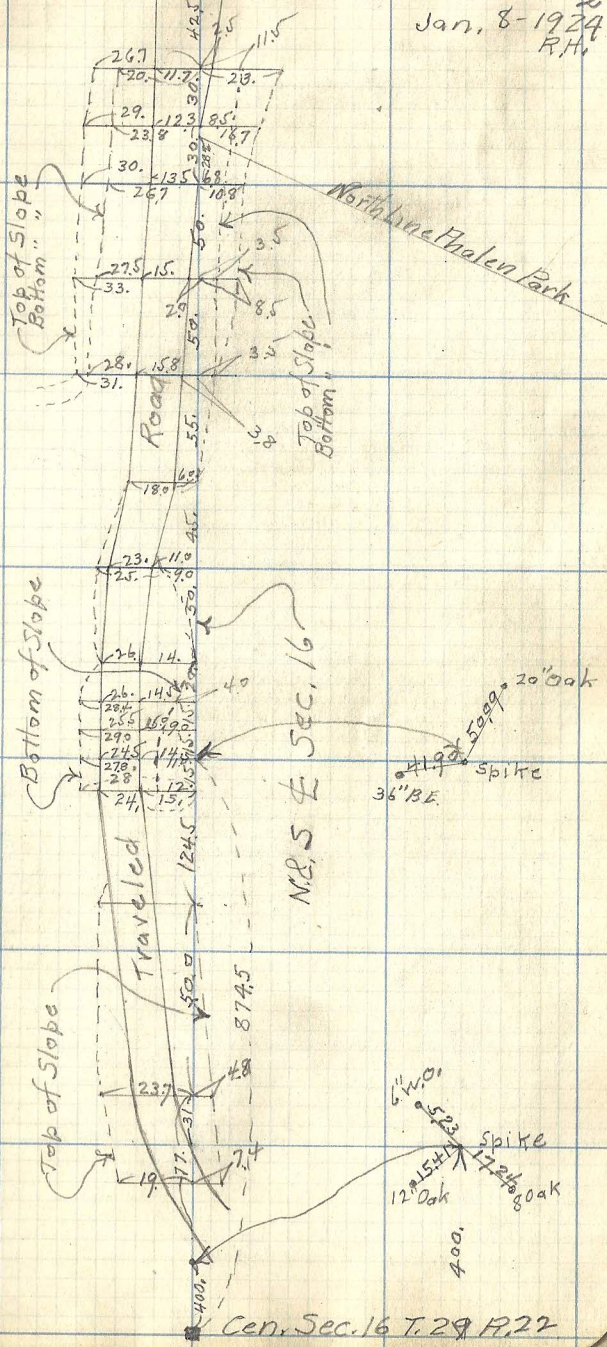

cen. Sec. 16 T. 29 R. 22