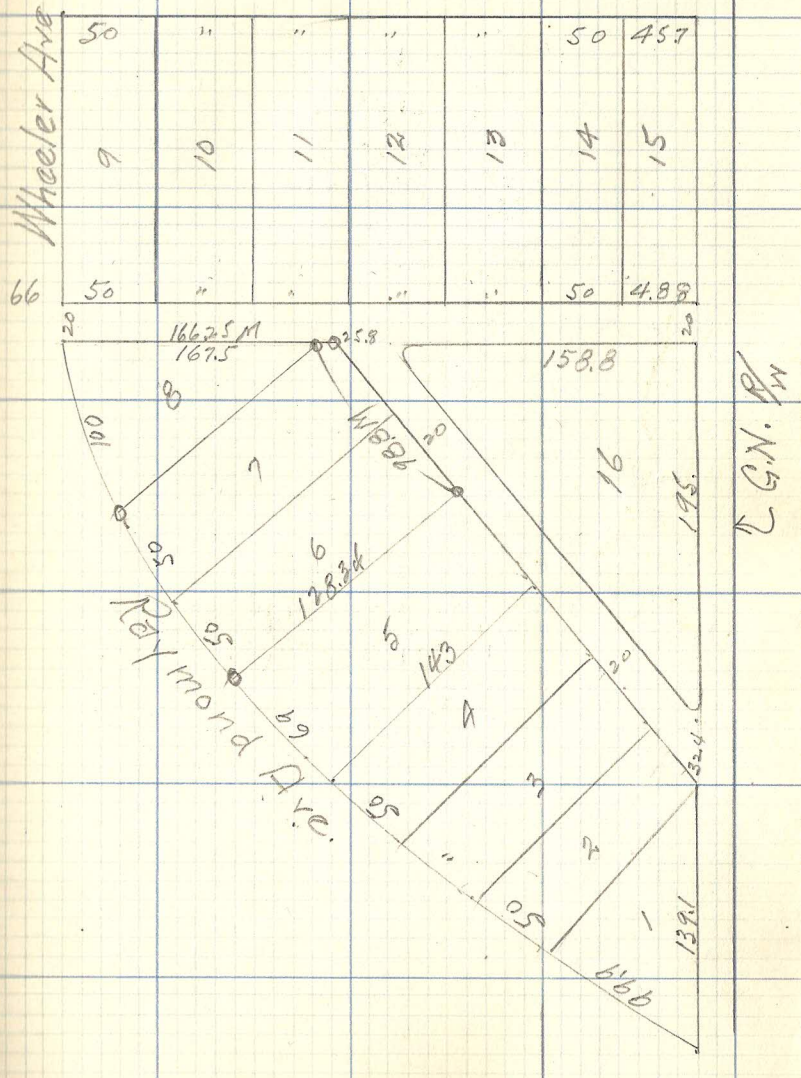Lot 6+7 Blk. 34.
St Anthony Park