


Lot 24 B/LK.30  
 Gotzians Re.Ar. of  
 Sigels Add.


30 60  
 60

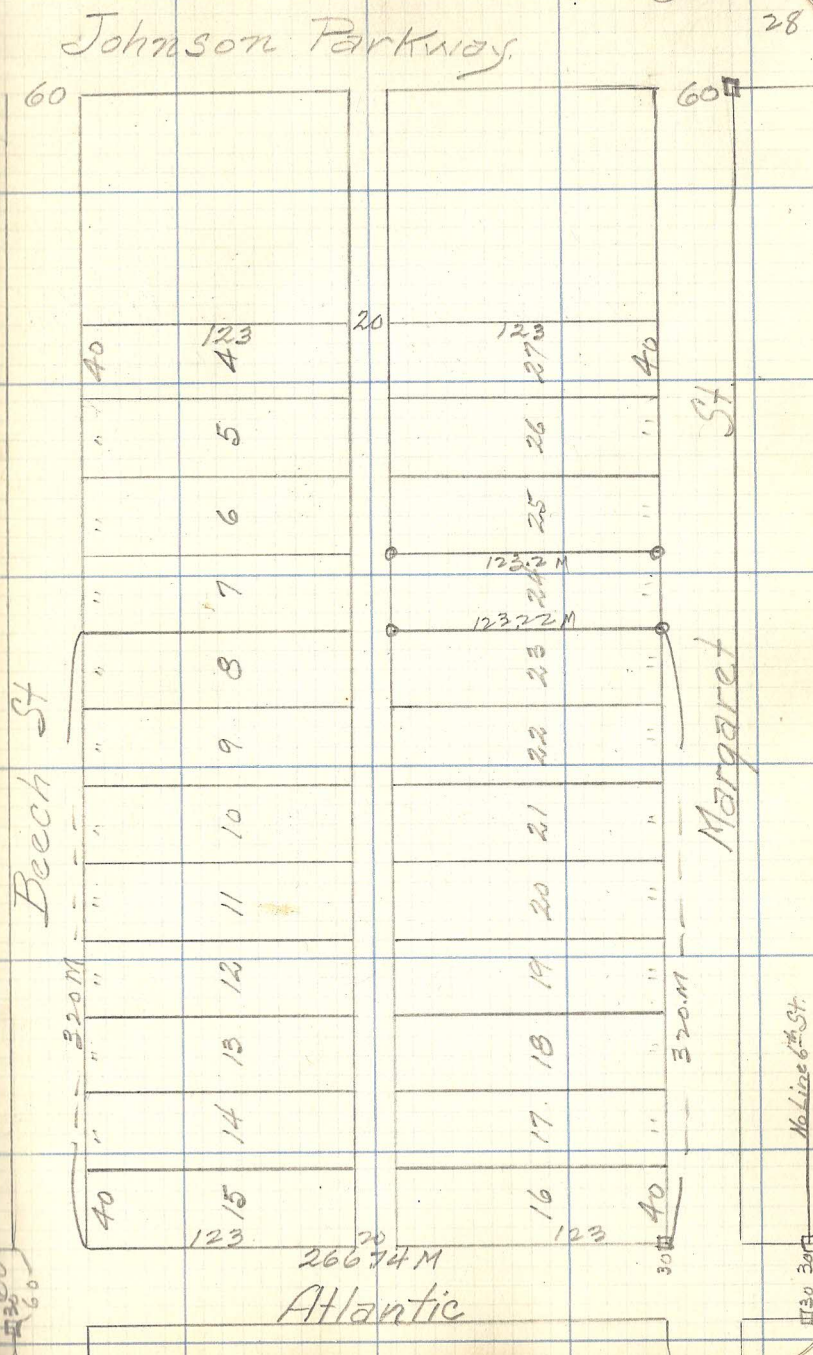

80  
 28