Jackson & Bidwell's Add.
the North 40 ft. of Lot 4 Blk. 19

Aug. 3-25

Lots 1 to 5 Blk. 18 Jackson & Bidwells Add.
Davids Re-Al.
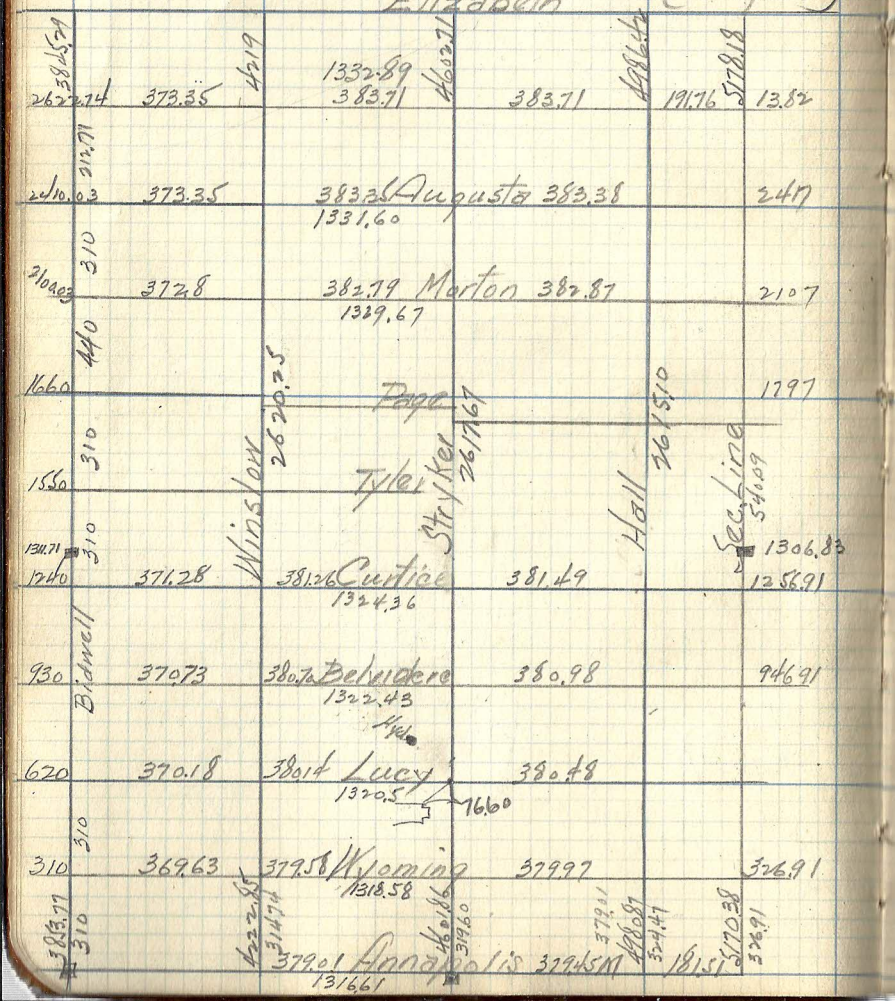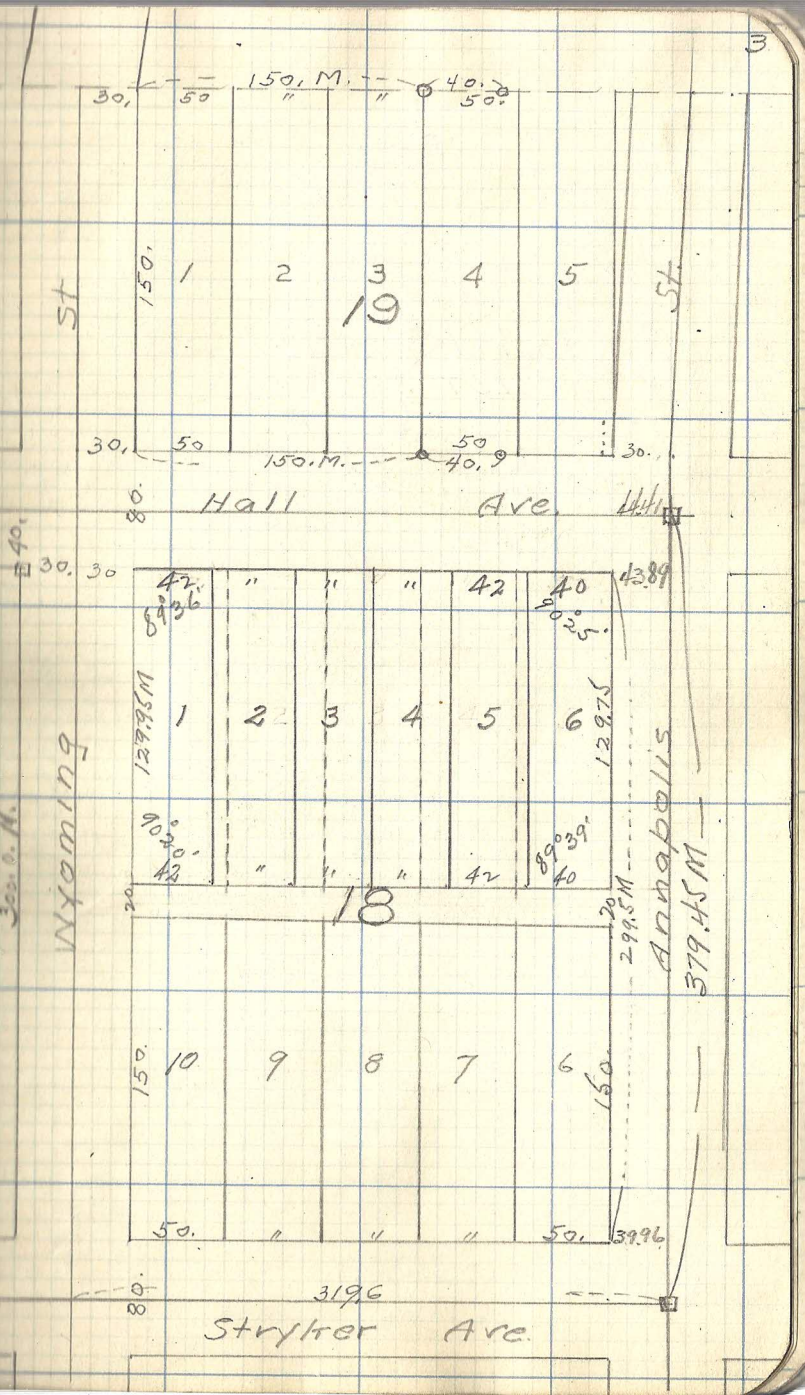
David H. Sullwold Owner.
Elizabeth (Single)