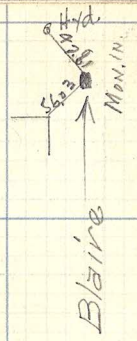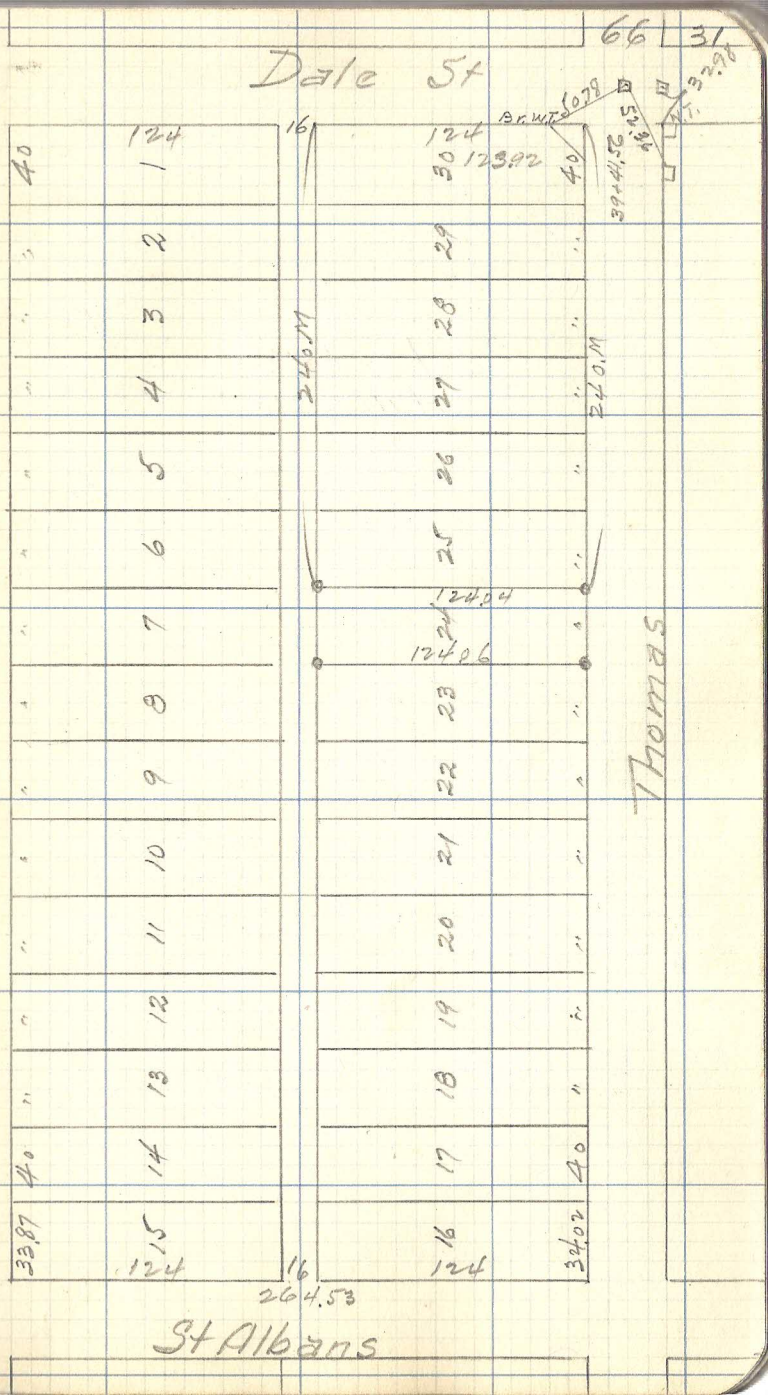Lot 24 Div. 4
Chute Bros. Div's.