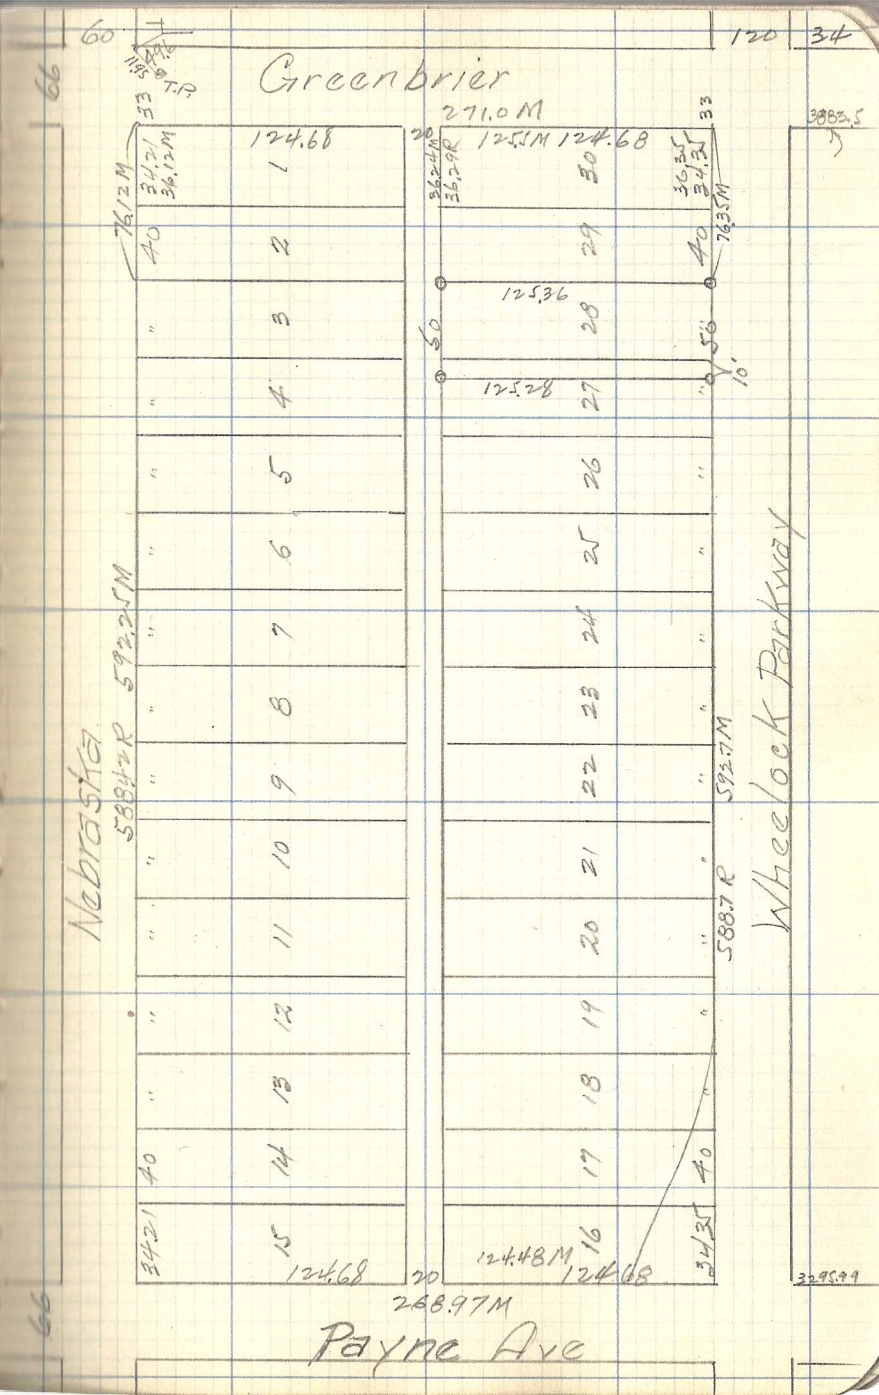Lot 28 & E. 10 ft Lot 27 Blk 12
Harrison & Handys Add.