


Location of
Con. Wall.

Lot 18-19 BK 10
Mae Kubin +
Marshall's Add.

F.N.C. Line
Security Surv. Co.

Con. Foundation

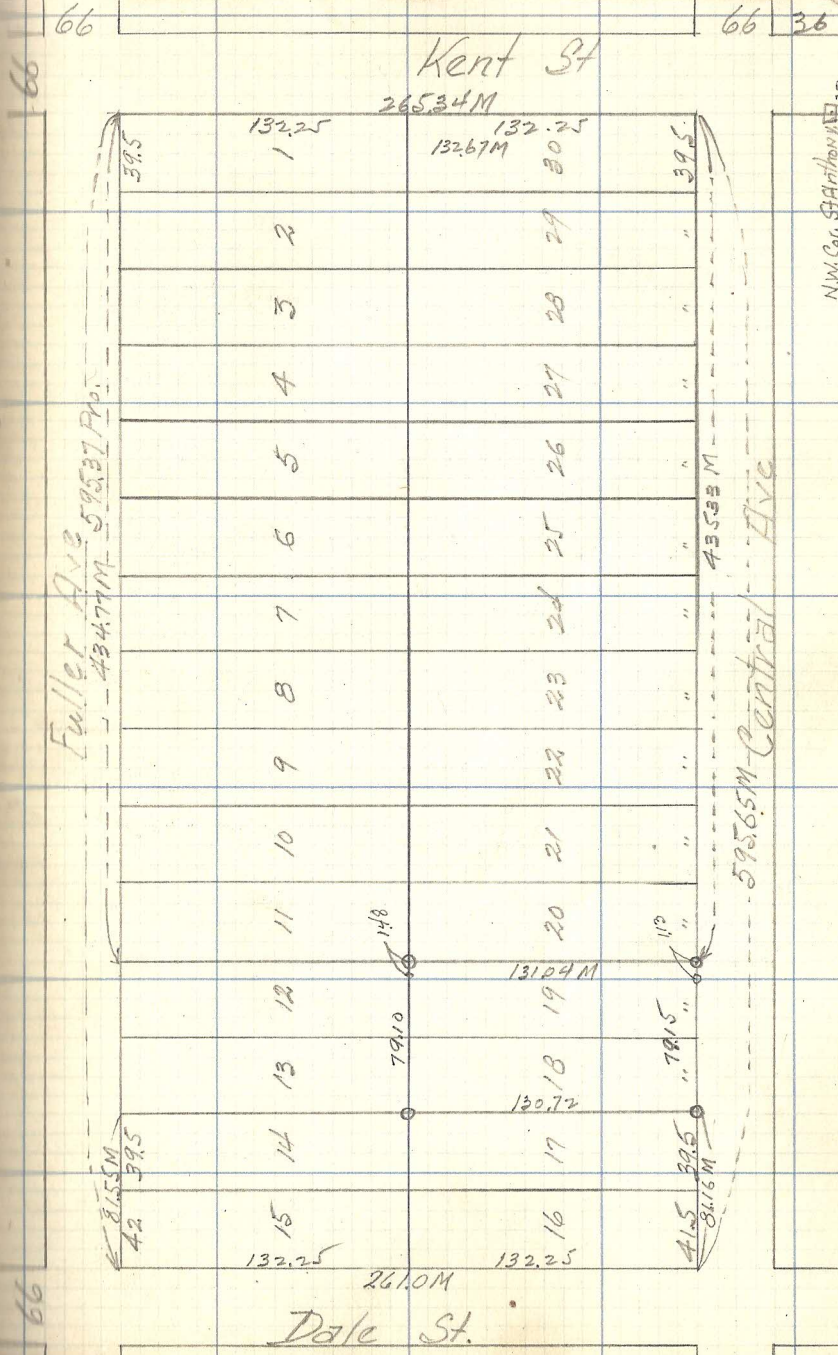

Kent St

Fuller Ave

Central Ave

Dale St.

N.W. Cor. Sta. Anthony 11/15