Saratoga To Warwick on Randolph.
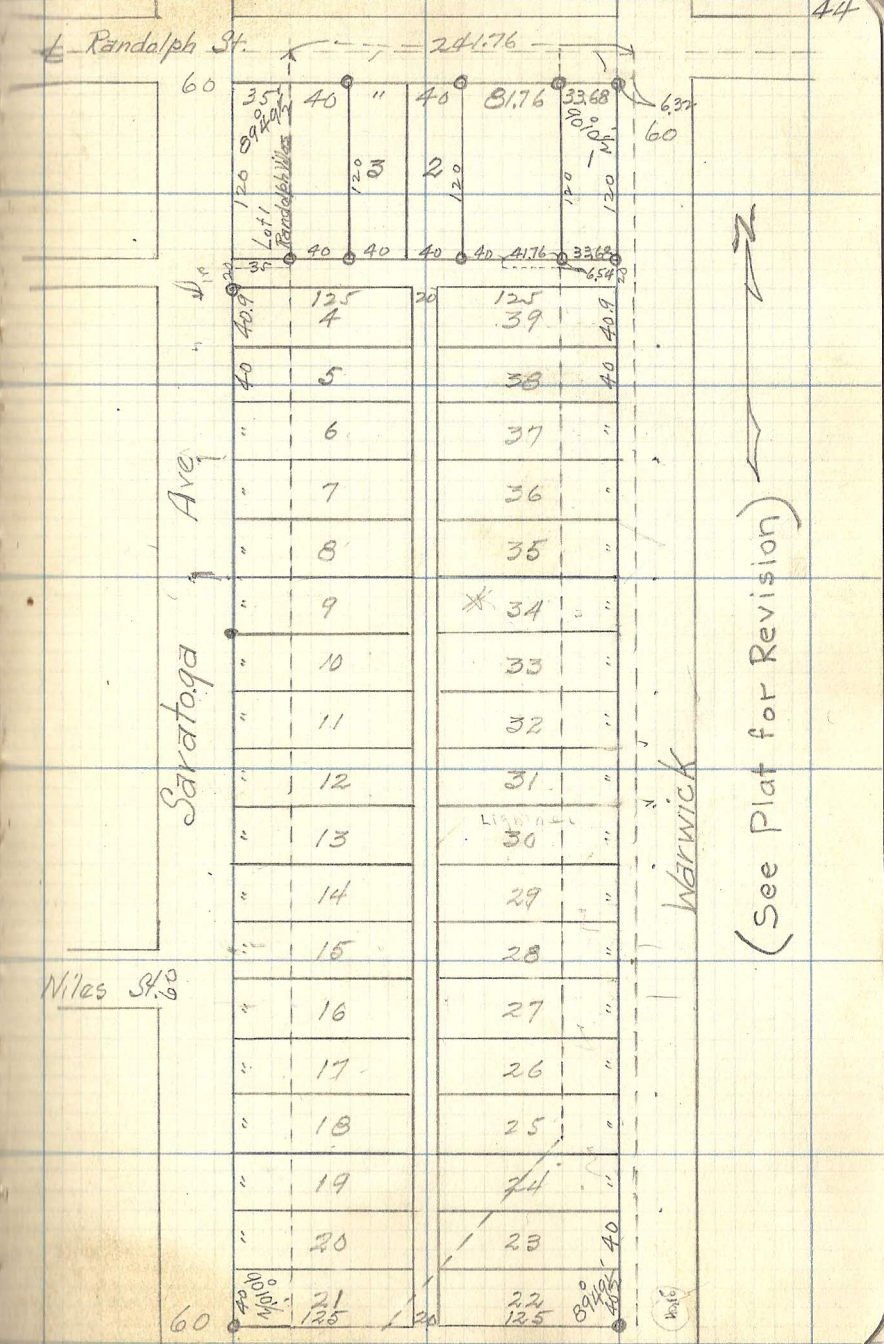
J. J. Kenna's