


Orosz Add.

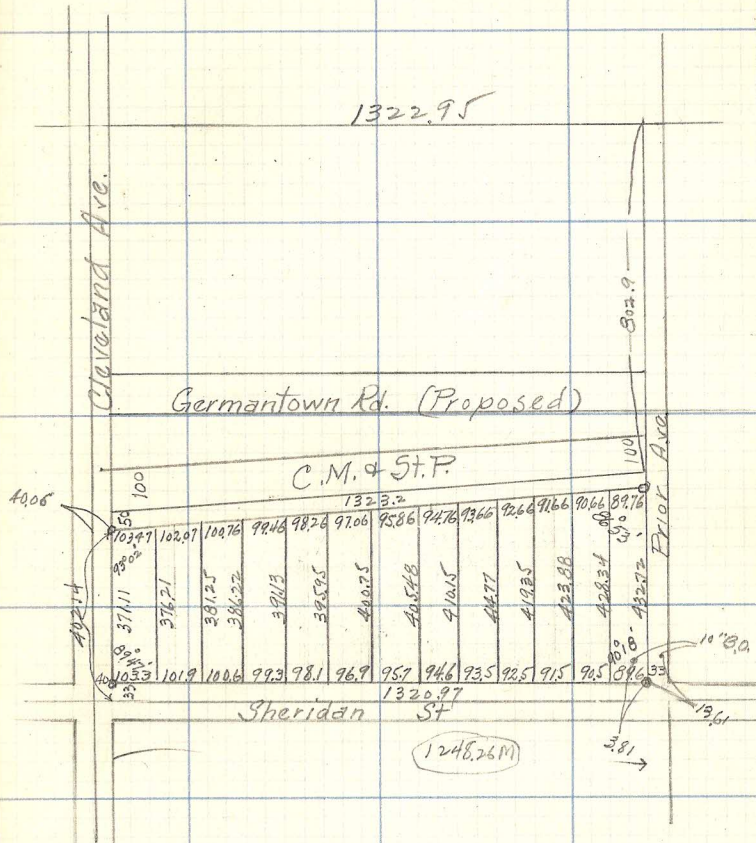

1248.26 M