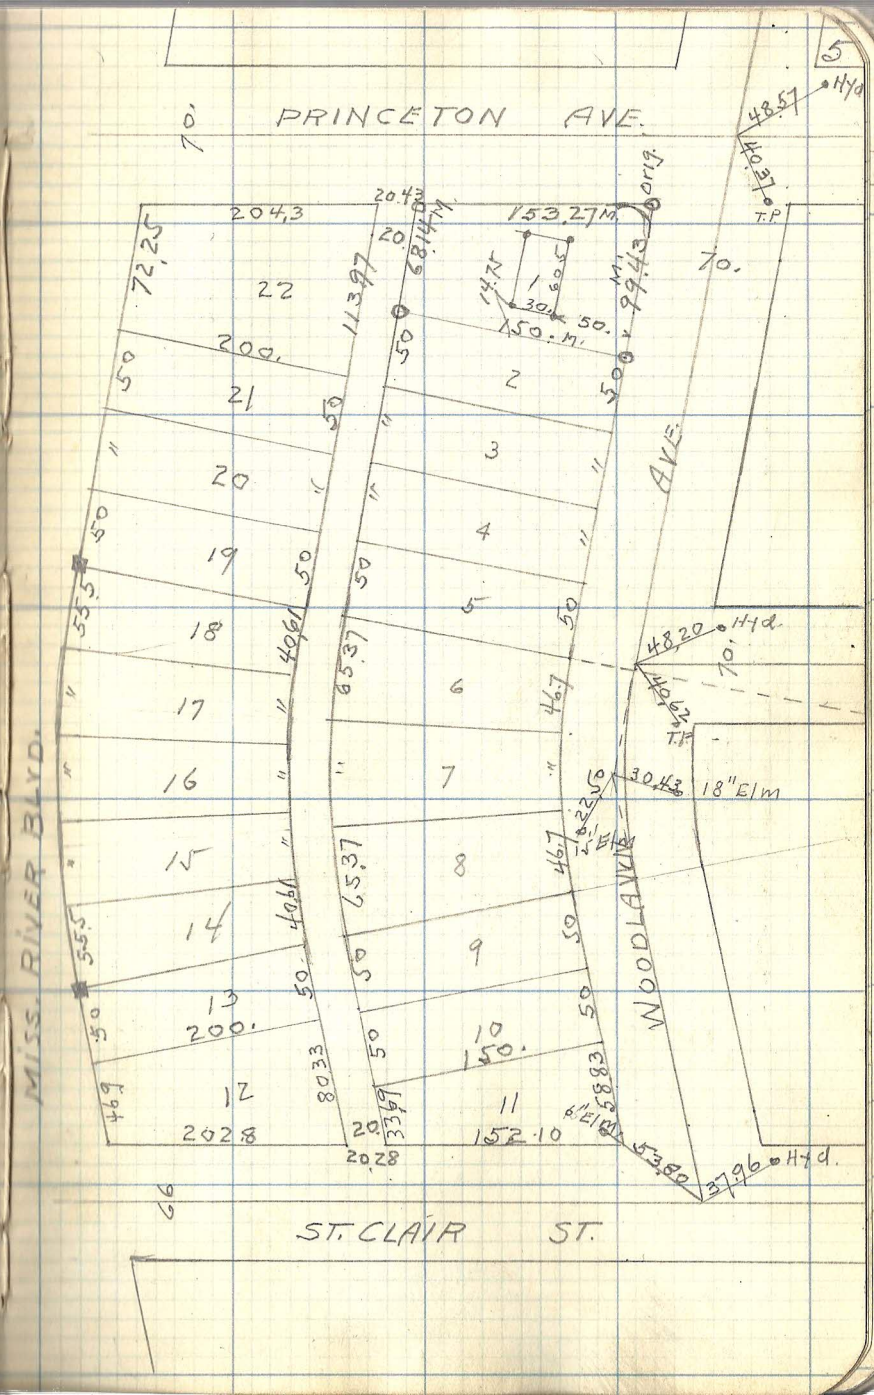KING'S MAPLEWOOD
LOT 1 BLK. 7
Feb. 17-25