



Farrell's Add.

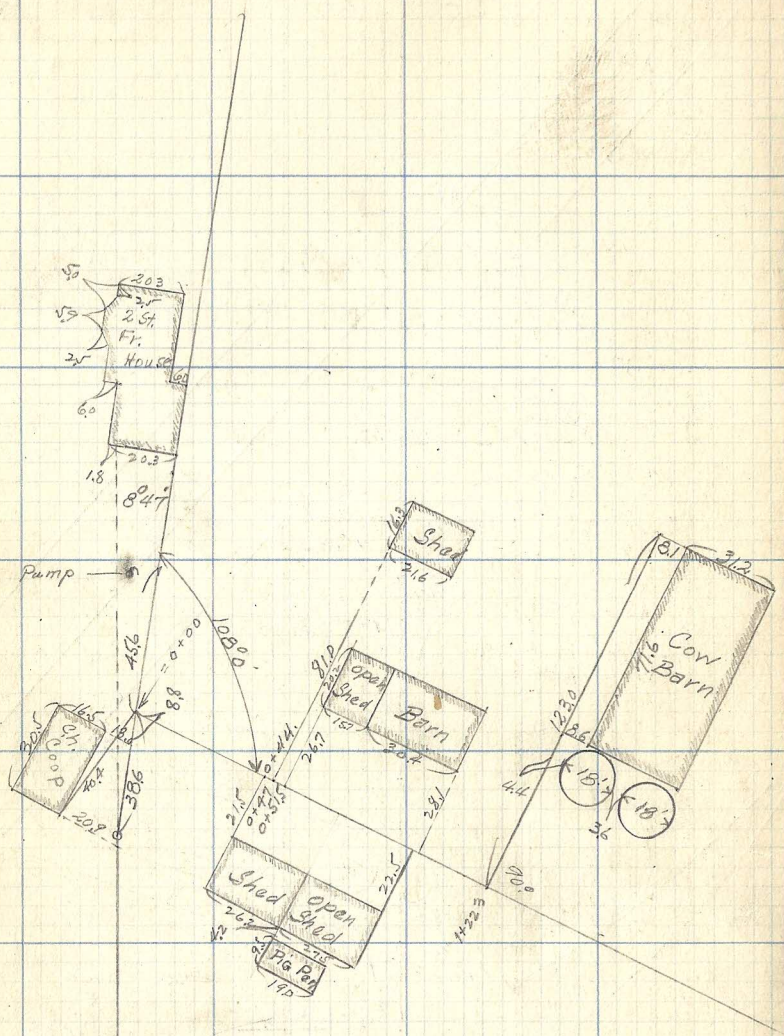

= N.W. Cor. Margaret & Farrell

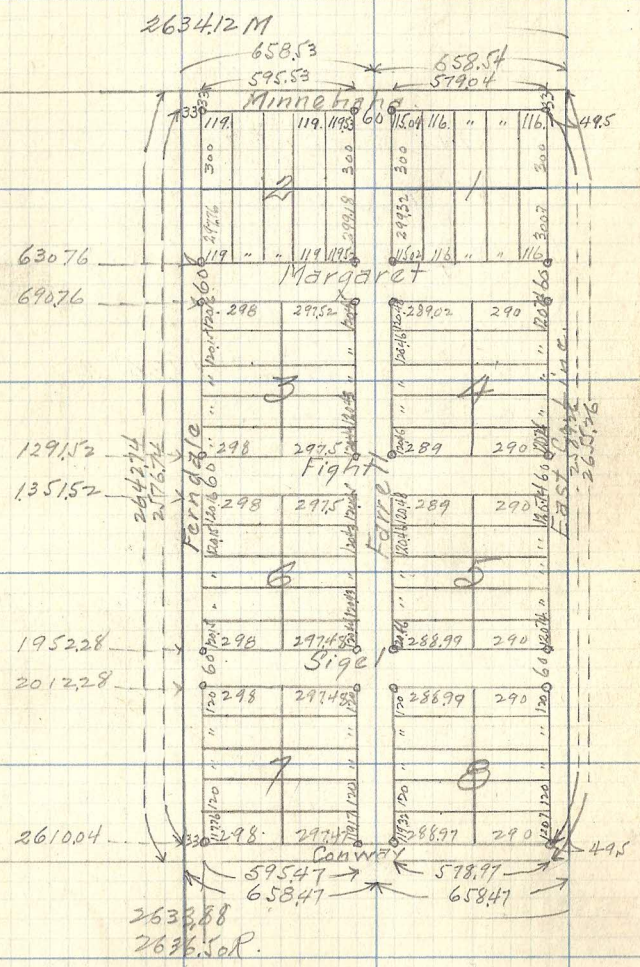

2630.72

2638.88
2636.50 R.