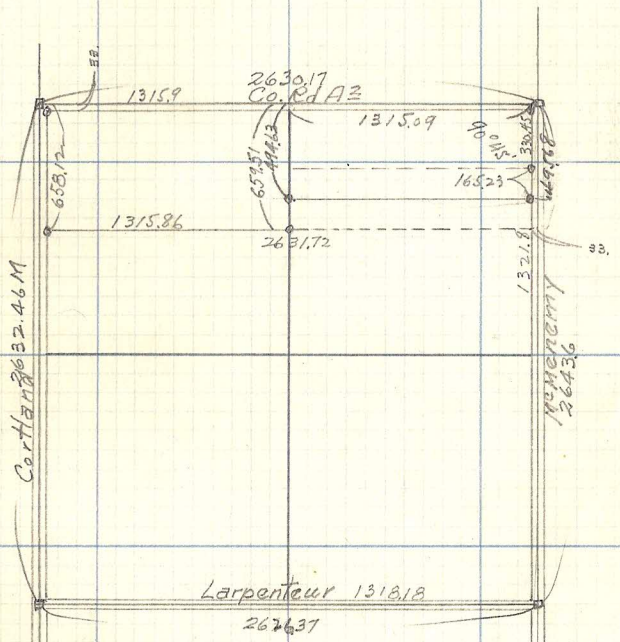N. ½ of N.W. ¼ of S.E. ¼
N½ of N½ of N.E. ¼ of S.E. ¼
N½ of S½ of N.½ of NE. ¼ of S.E. ¼
N¾ of N.½ of N.E. ¼ of S.E. ¼
Sec. 18-29-22
May 18-1926