Gilbert & Gilbert
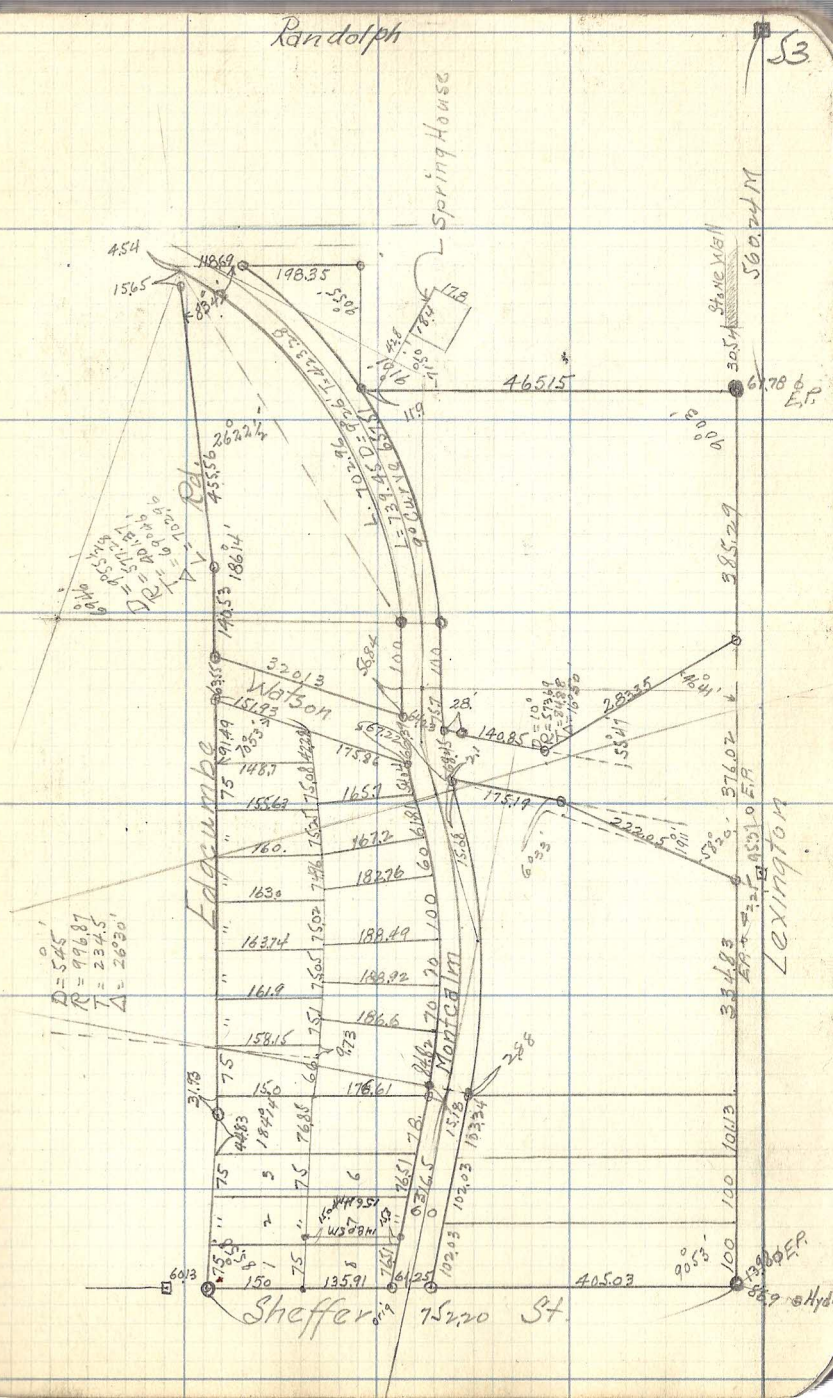
Edgcumbe Rd. & Montcalm.