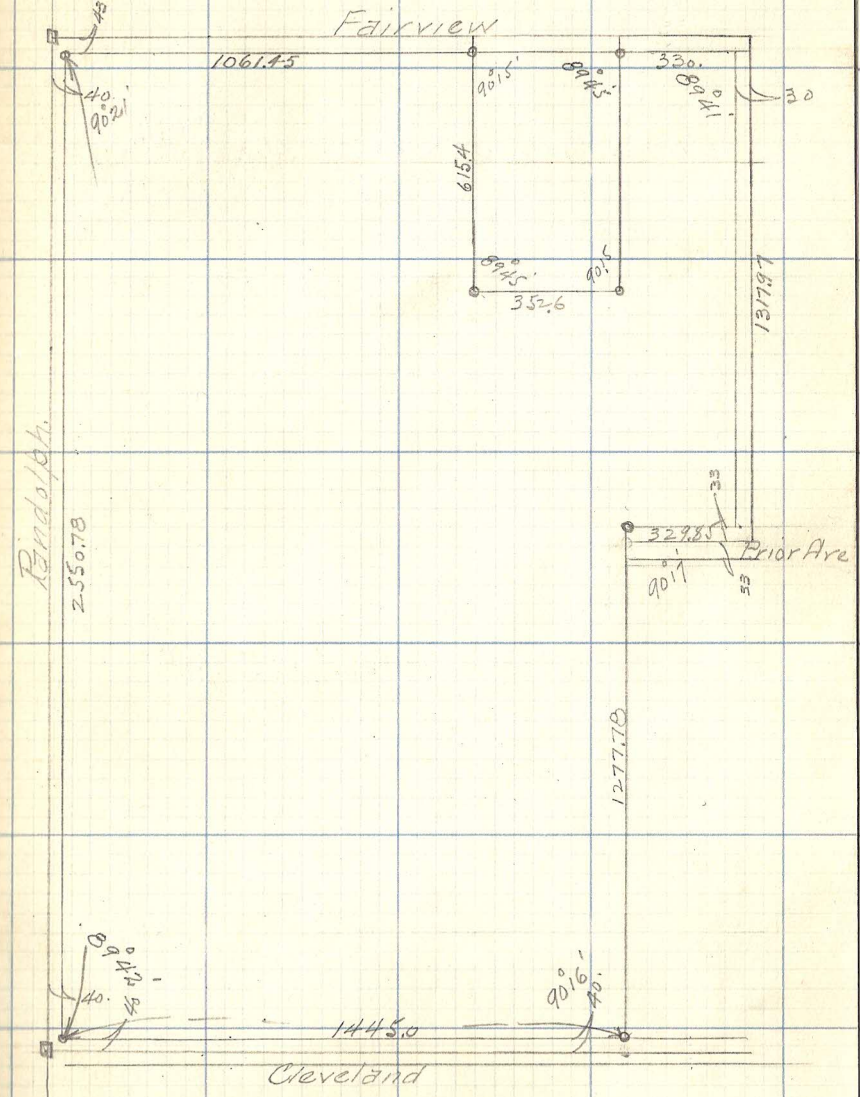Grounds of the Collage of
St Cathrine.