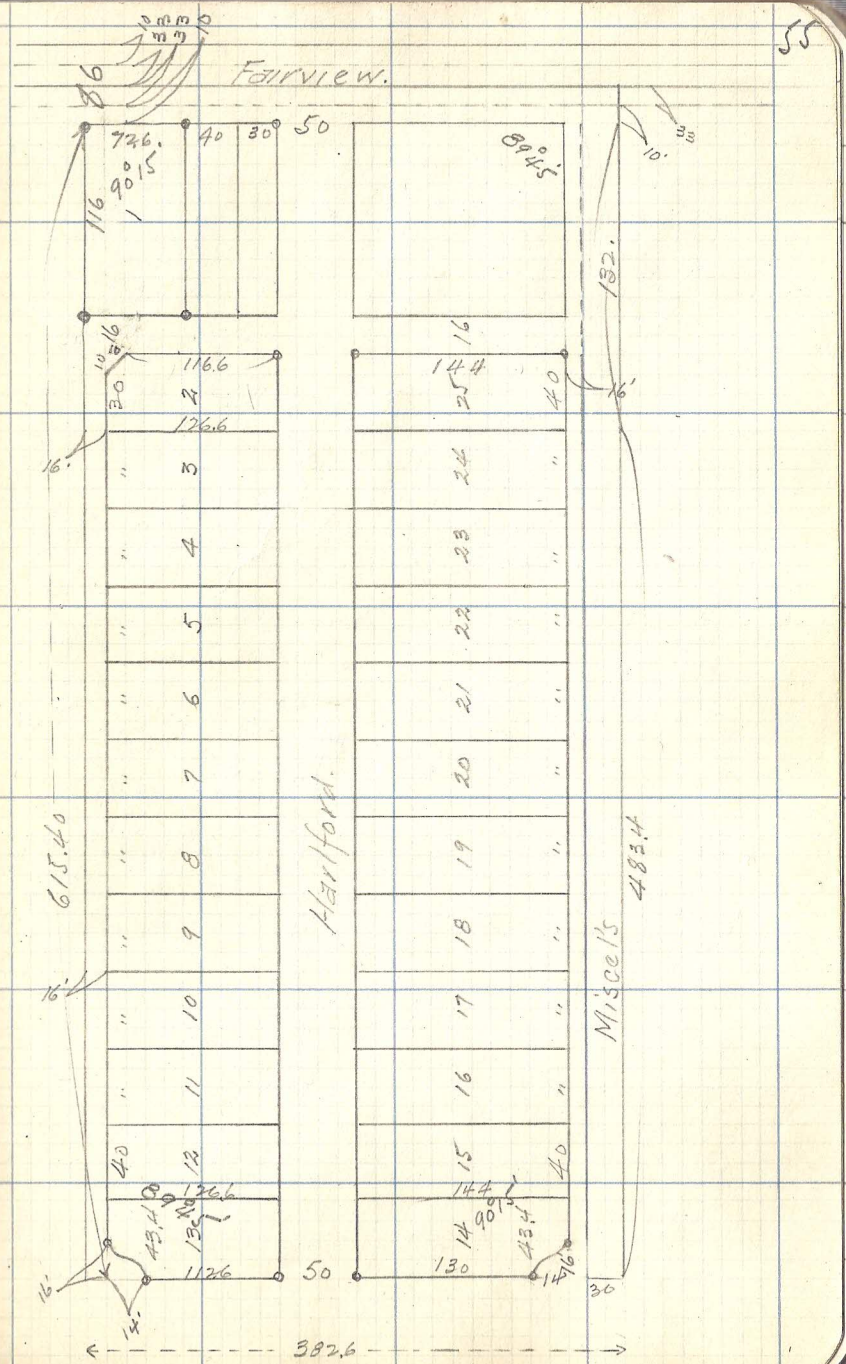John Gaarden's 5th Add.