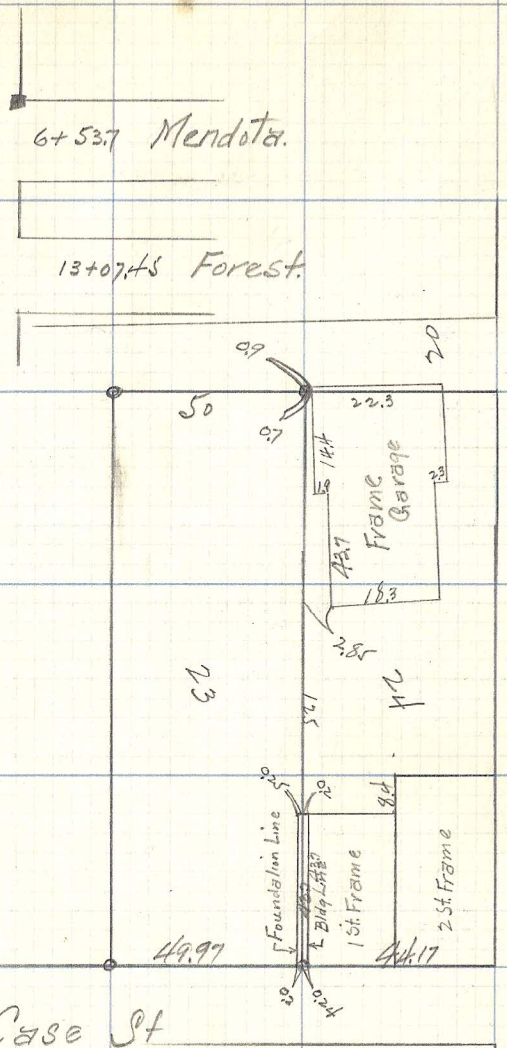

Lot 23 Blk 1 Nelsons Add.
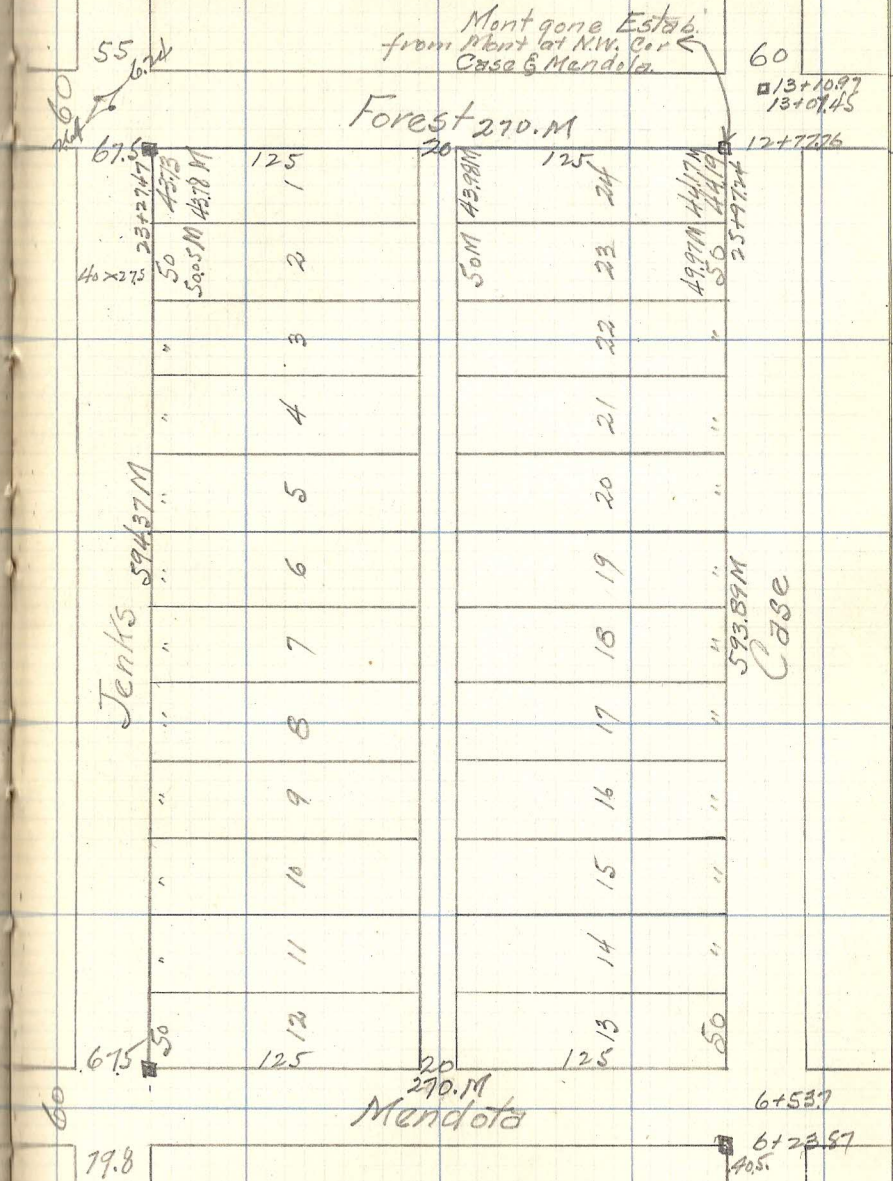
June 27-27