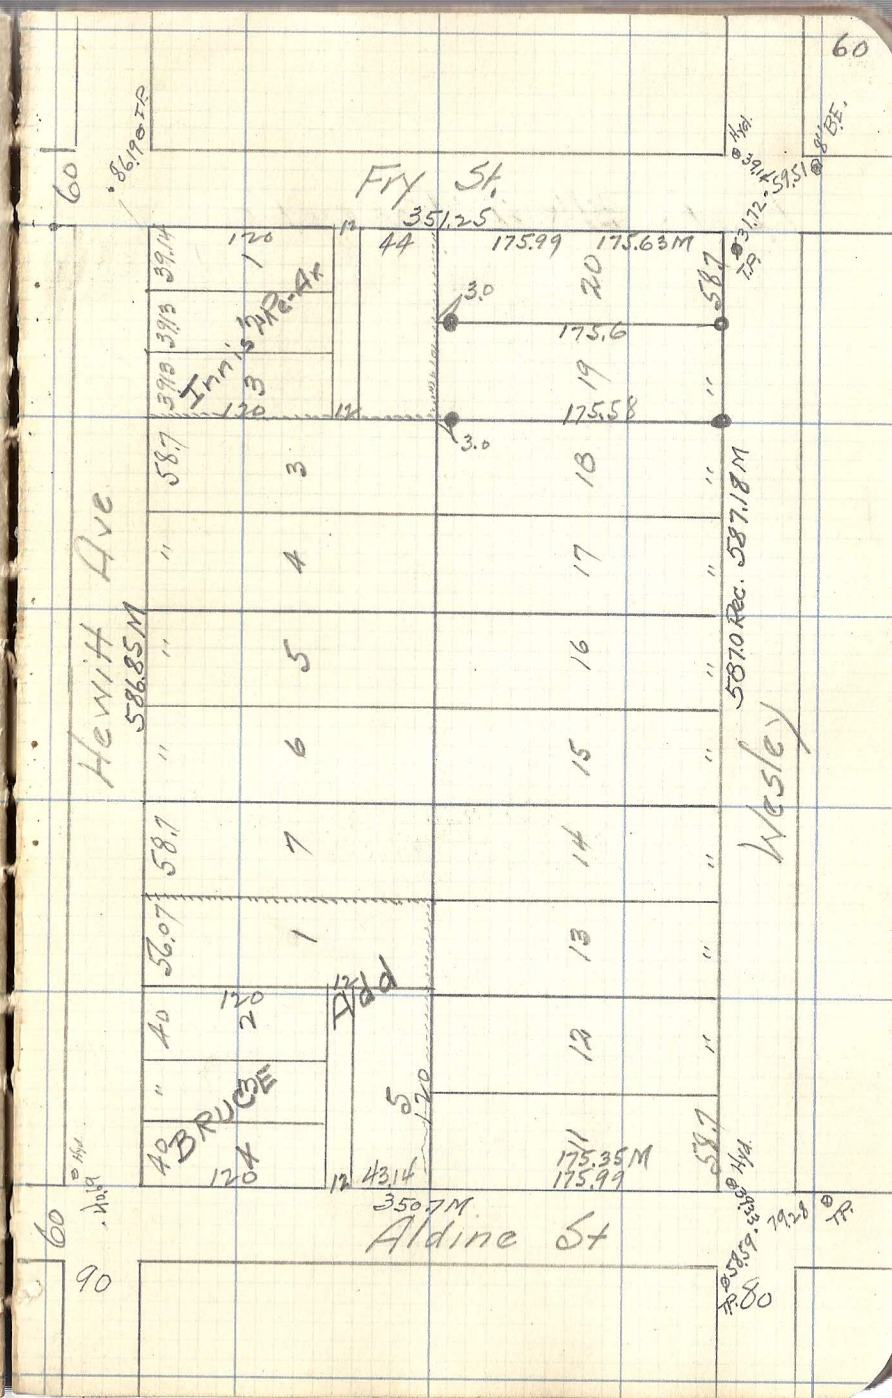Lot 19 Blk 2 College Pl.
West Div.