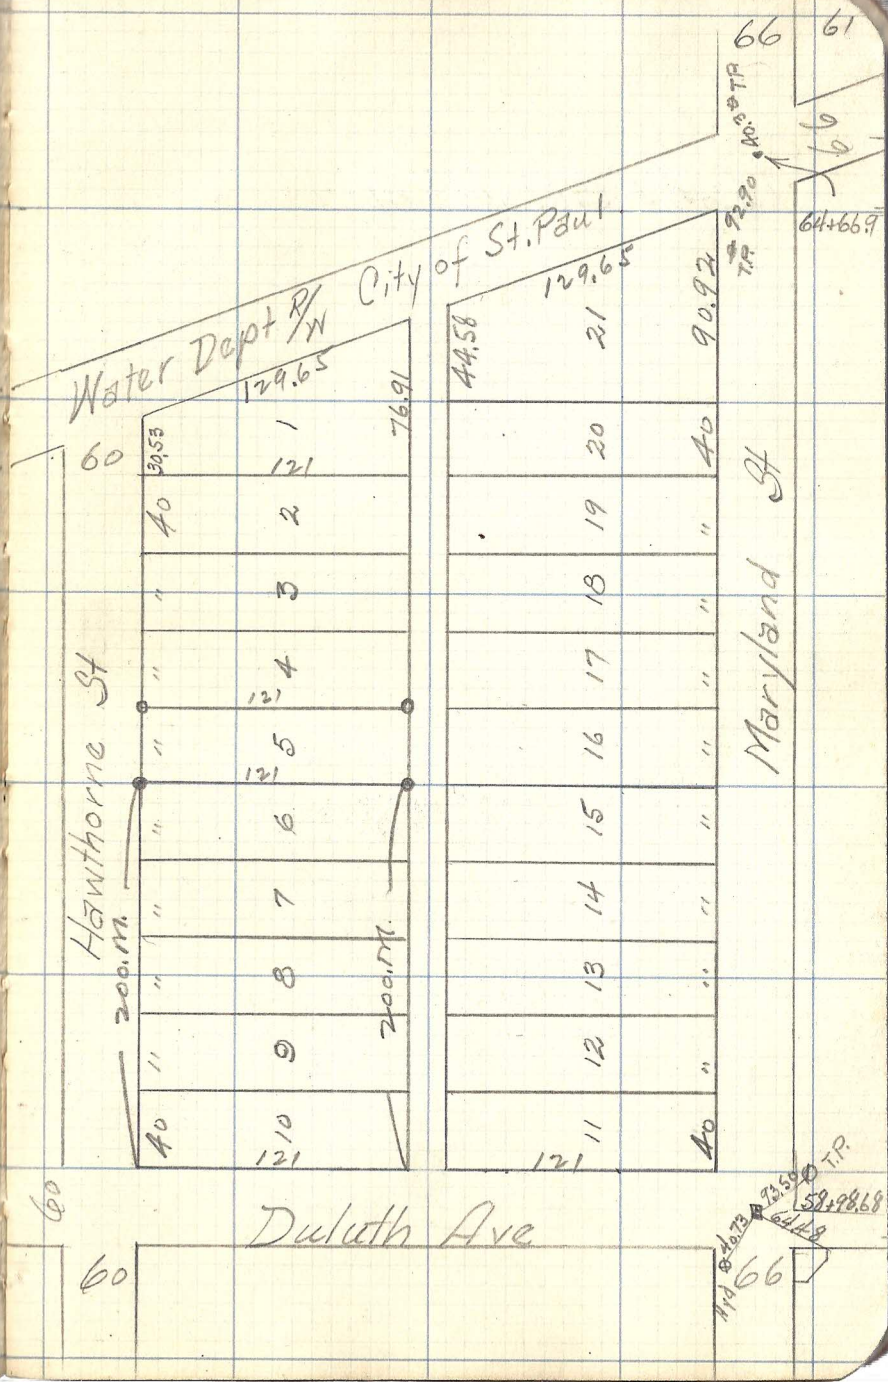Lot 5 Blk. 10 Phalen Heights Park.