Sec. 33-30-23

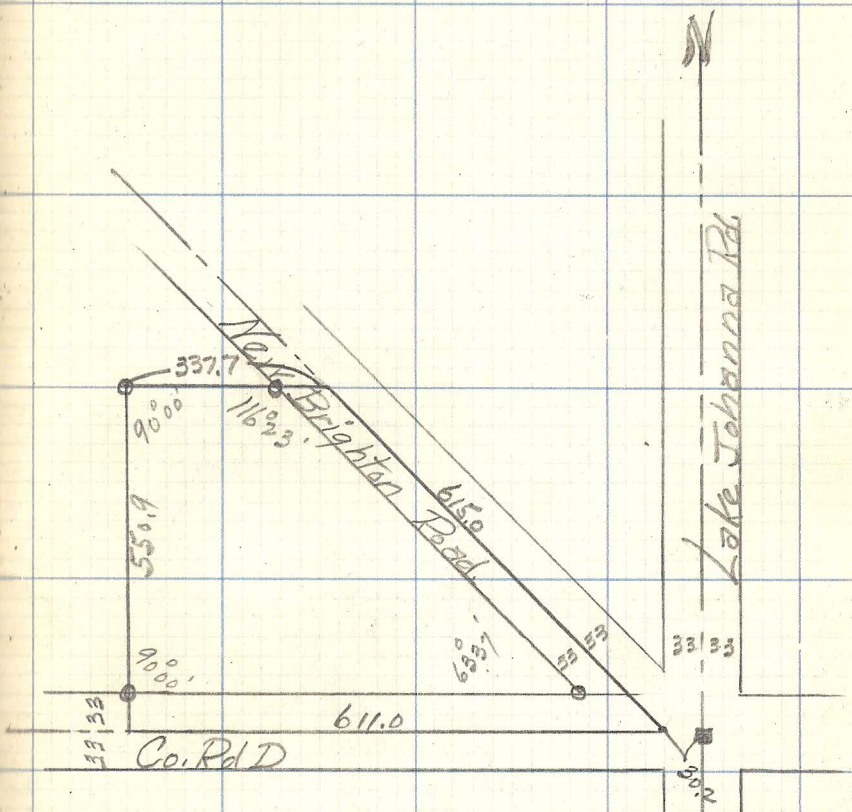
N
337.7
90°00'
116°23'
550.9
6150
633.7
90°00'
33
33
611.0
33
33
Co. Rd D
30.2