


Lexington

579.15M

Central Ave. 1927

60' Hwy  
135' Hwy  
100' Hwy  
40' 40' 50'

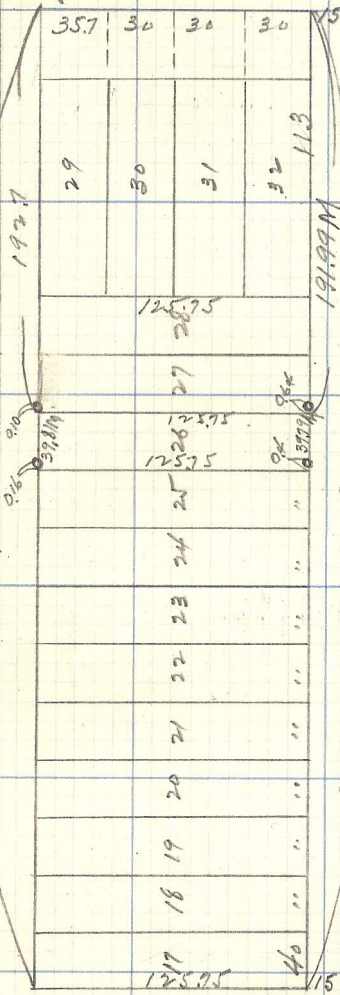

St Anthony's

589.9M

191.99M

1927

35.7 30 30 30

29 30 31 32

113

125.75

575.2 575 OK 300

50

40

125.75

15