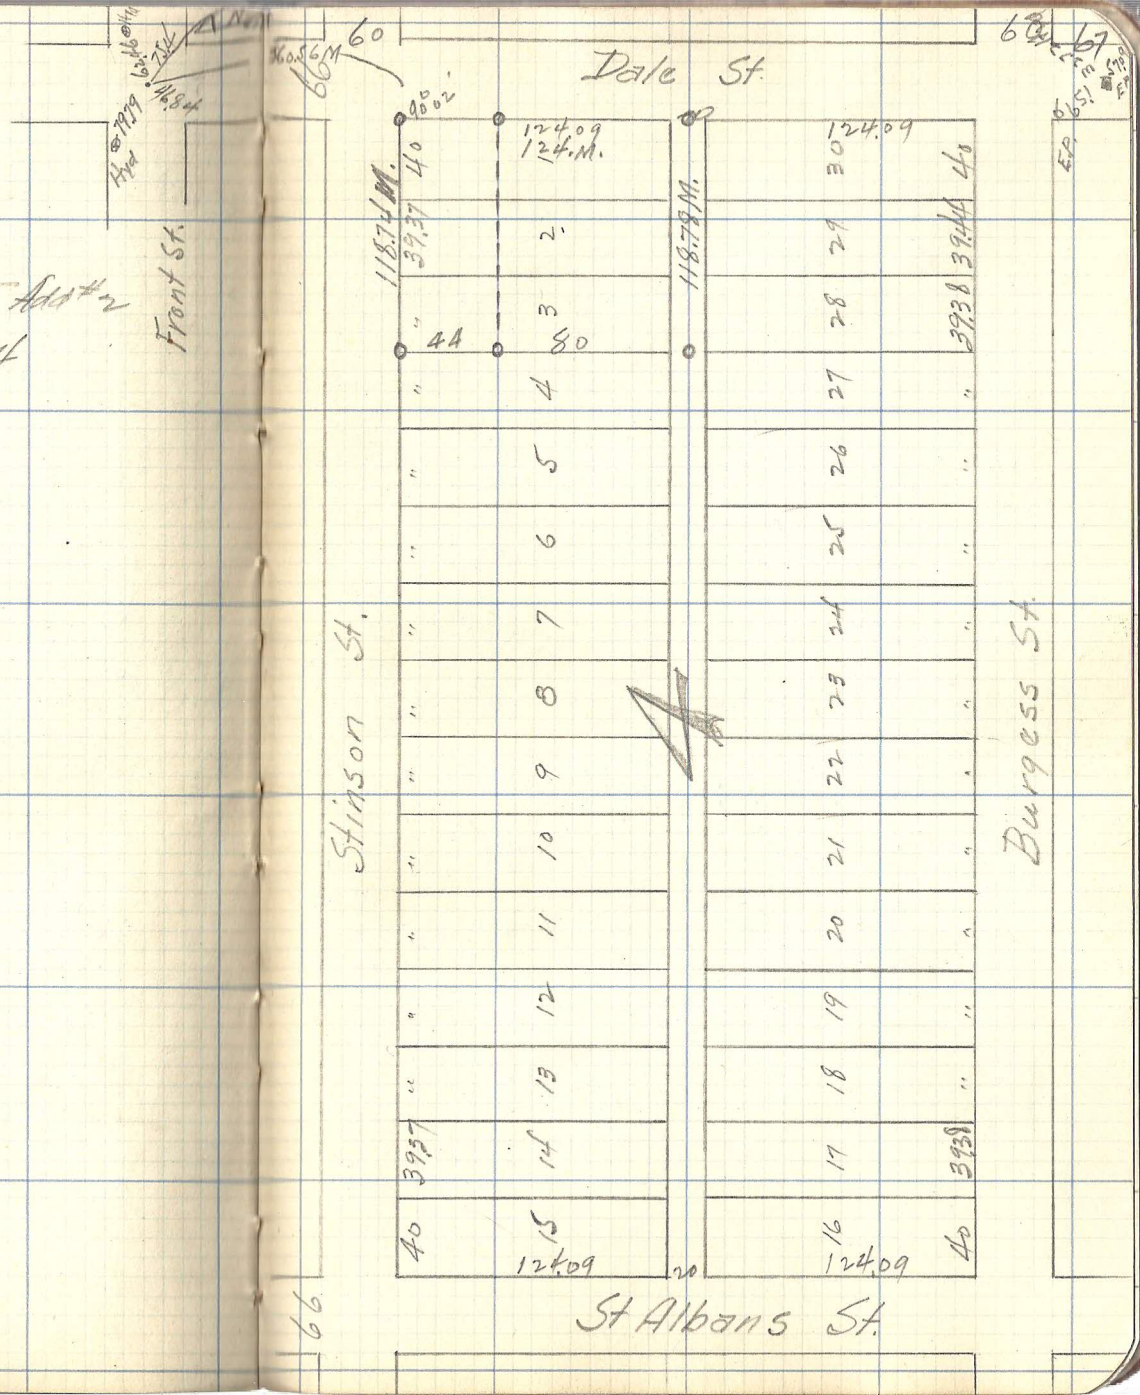Butterfield Syndicate Add^n 2
Lots 1-2-3 Blk 4