


Lot 7 Blk. 14 Holcombe's Add.

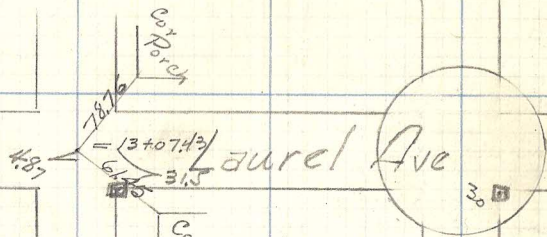

Ashland = 16+28.9


Grotto

Holly = 19+53.9

Portland = 22+79.4

Summit = 26+11.9


St Albans

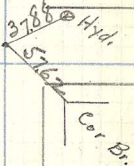

26+15.64

13+23.73

6+61.86

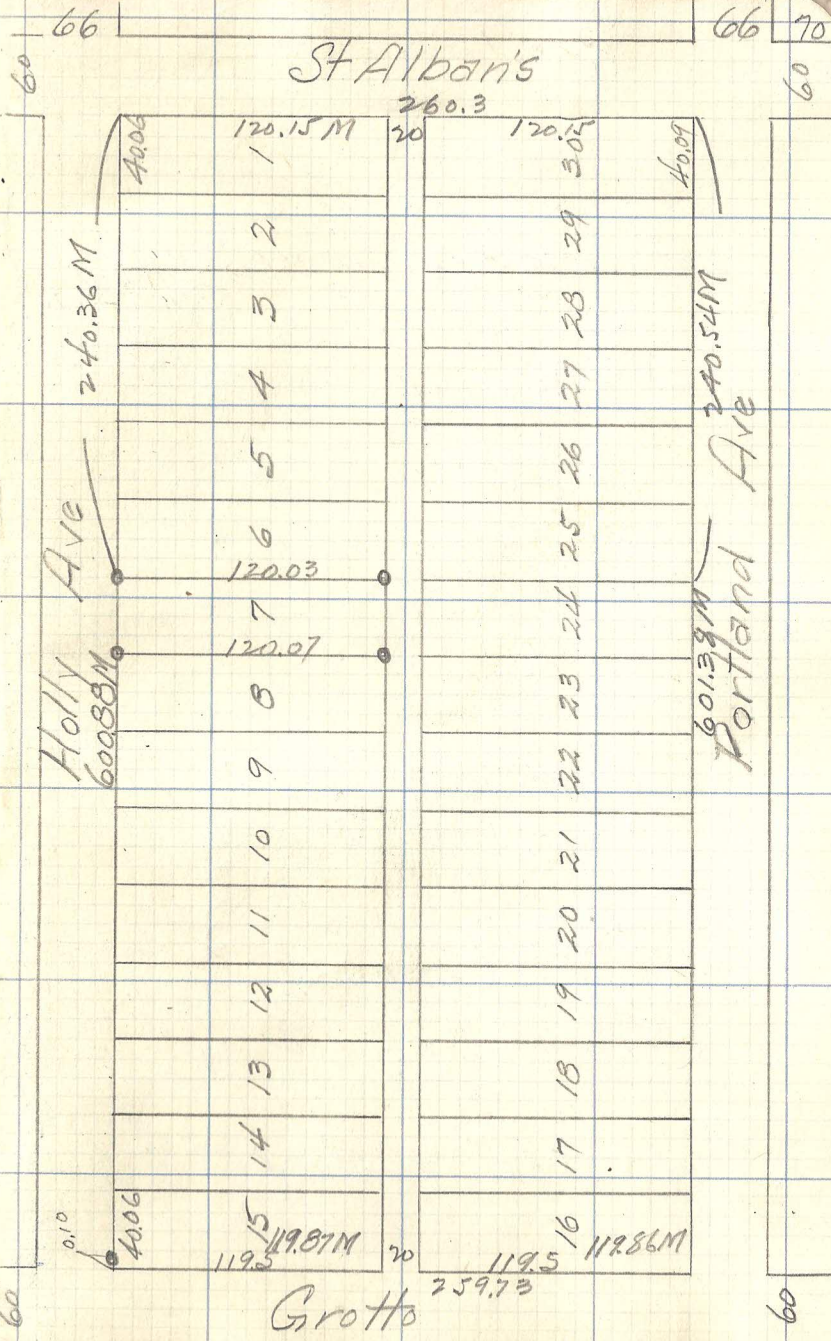

St Albans

Holly Ave

Portland Ave

Grotto