

Hyd. 45.12 2510.64
 59.61 Mon.
 Marshall
 4315 Hyd.
 93.99

Est. from ties at Selby Mont
 NE. Cor. Dayton. & Mont. Cor. Marshall 80

213077 Dayton
 Lot 18 Blk. 3 Skidmores & Cassidy's
 Park Add.


Hyd. 59.84 54.26 Hyd
 162942 Selby
 Hyd. 45.58 56.67
 102.42
 12

1545.15 Hague

128071 Laurel
 894.1 Ashland

508.7 Portland

Summit

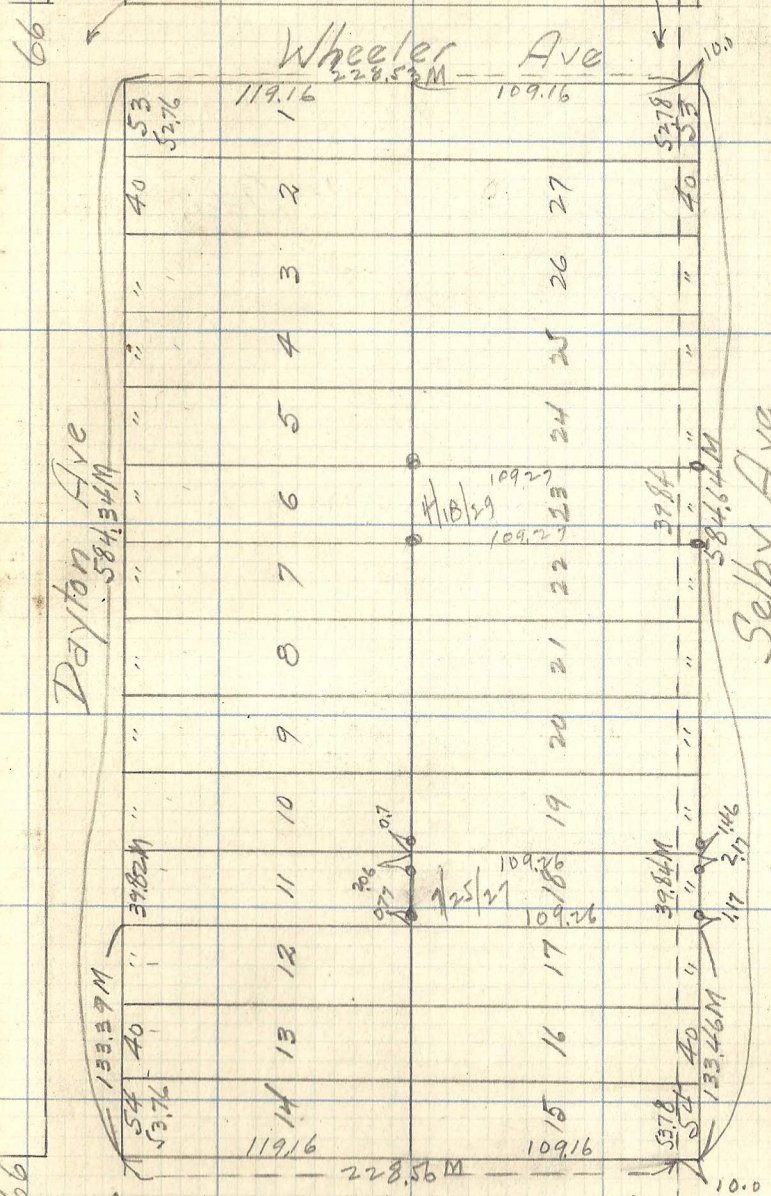

1/4 Line Est from 1/4 Cor. Mont at Summit
 to Mont SE. Cor. Marshall 80