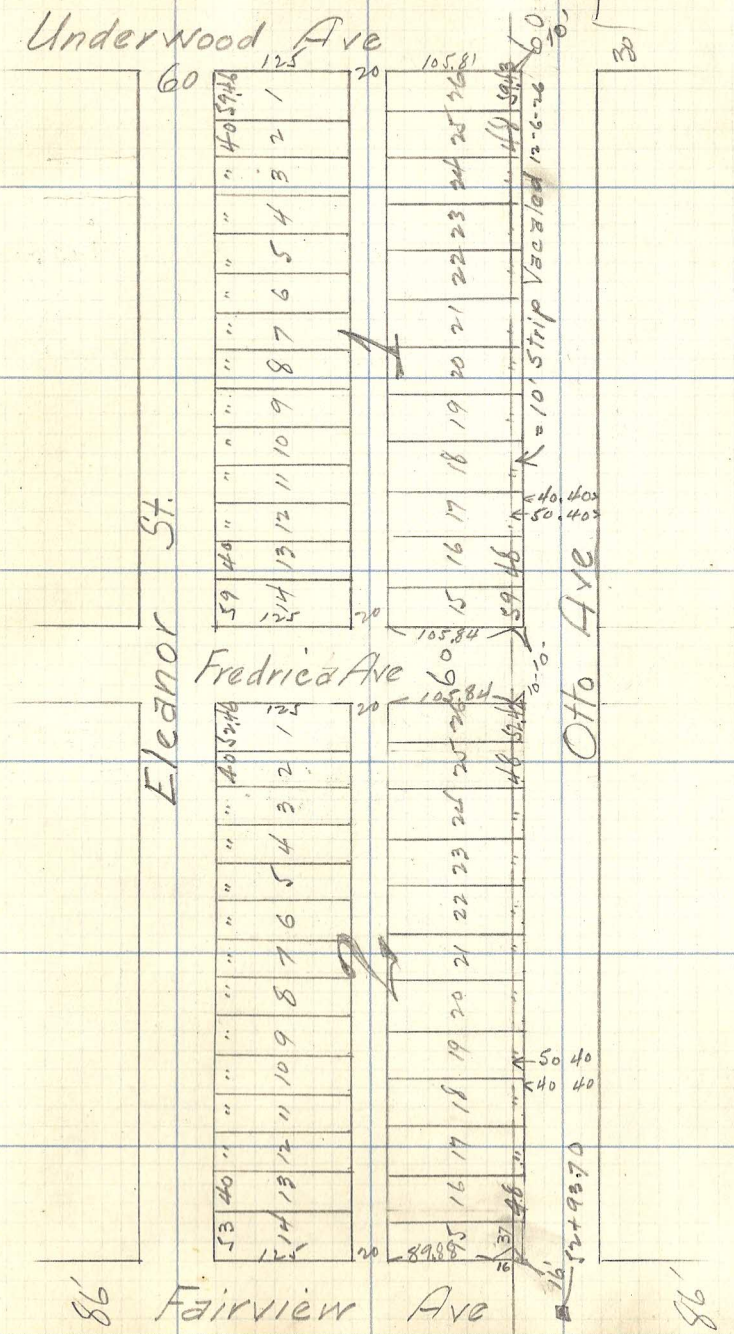John Gaarden's Add.