Copy page 26

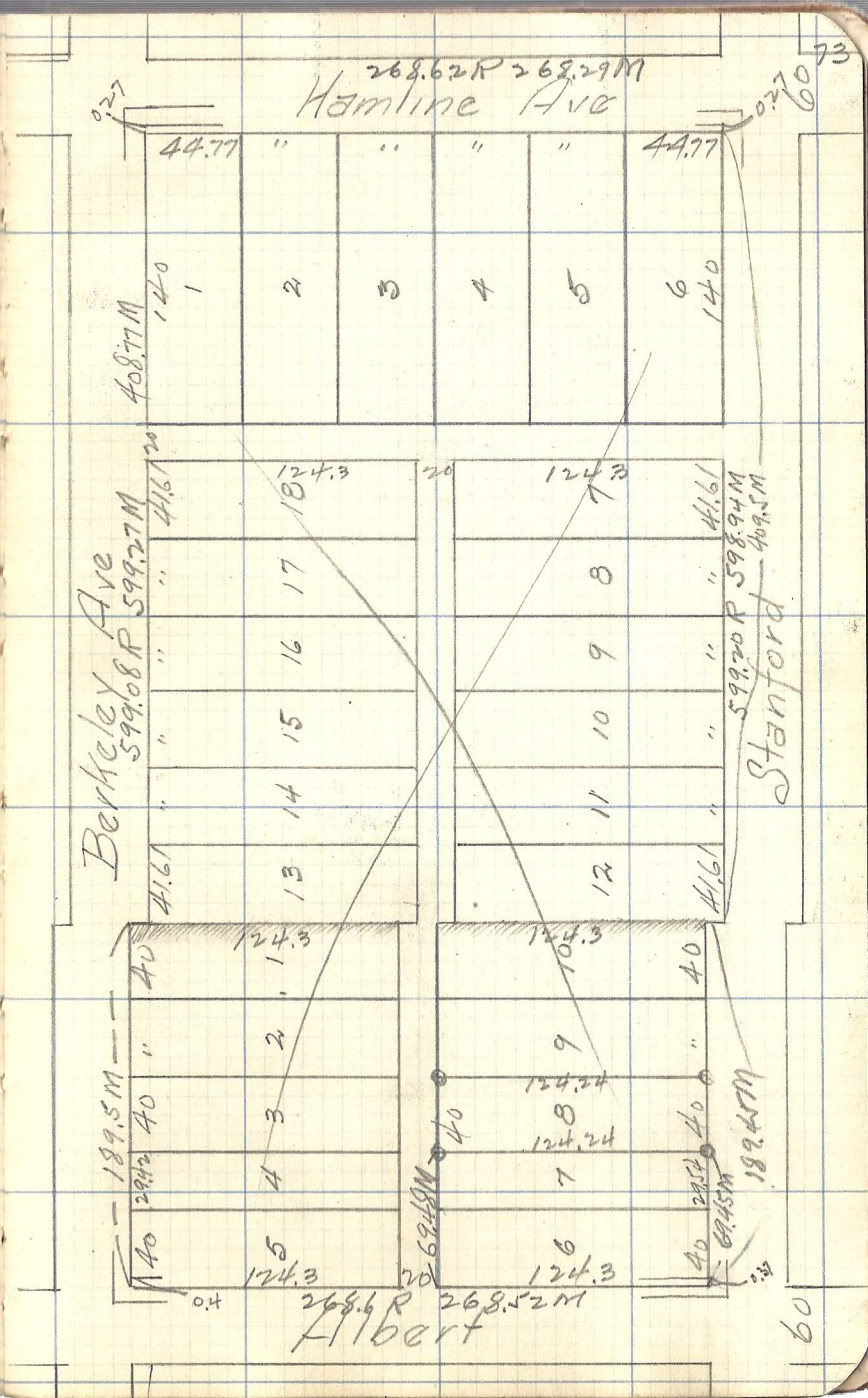
268.62R 268.29M
Hamline Ave
44.77
40
124.3
Berkeley Ave
599.27M
599.08R
Stanford
599.20R 598.94M 599.5M
189.5M
189.4M
268.6R 268.52M
Albert
60
73