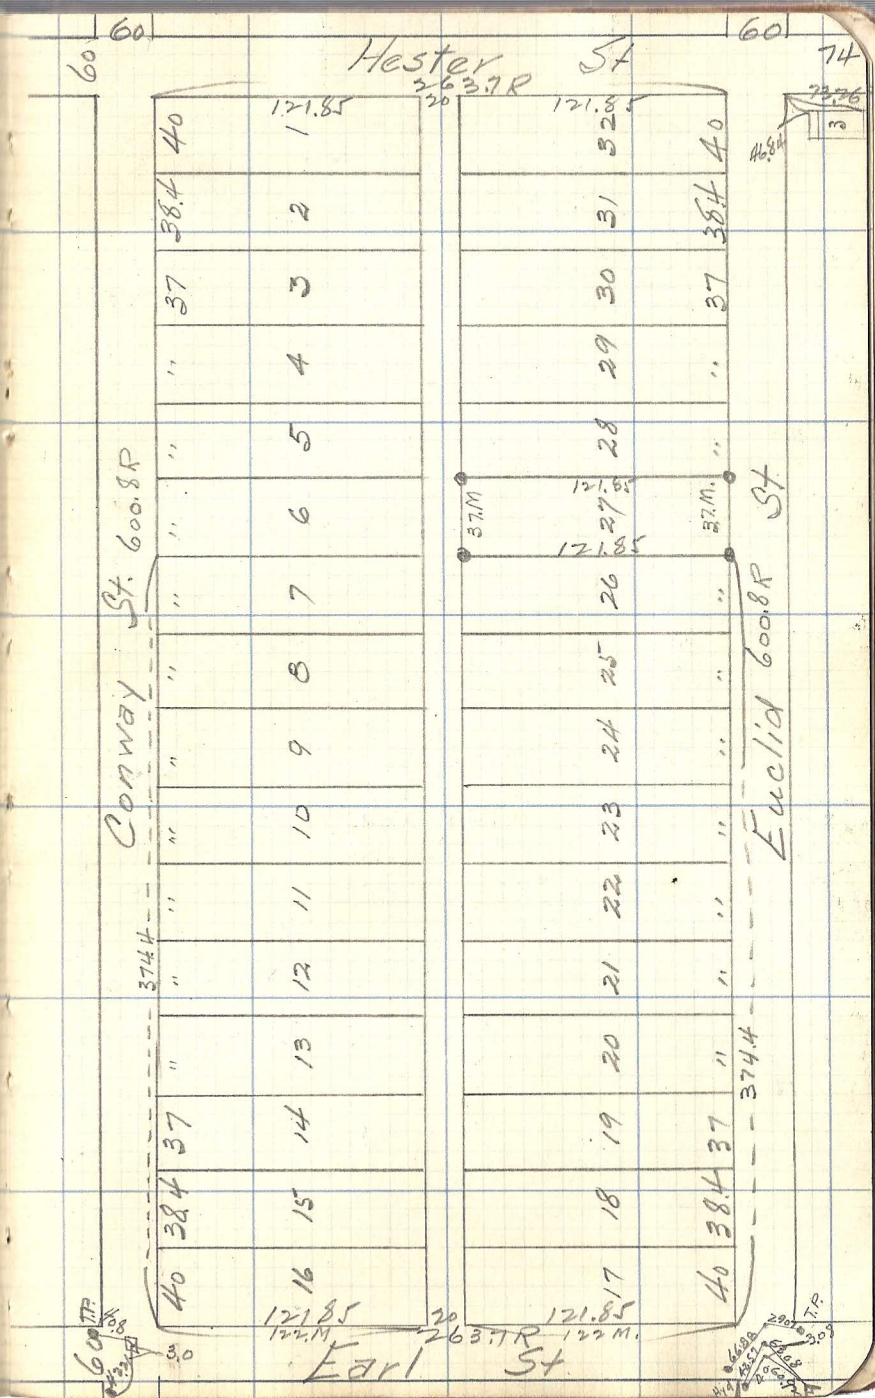Lot 27 Blk 1 H.F. Schwabes Add.