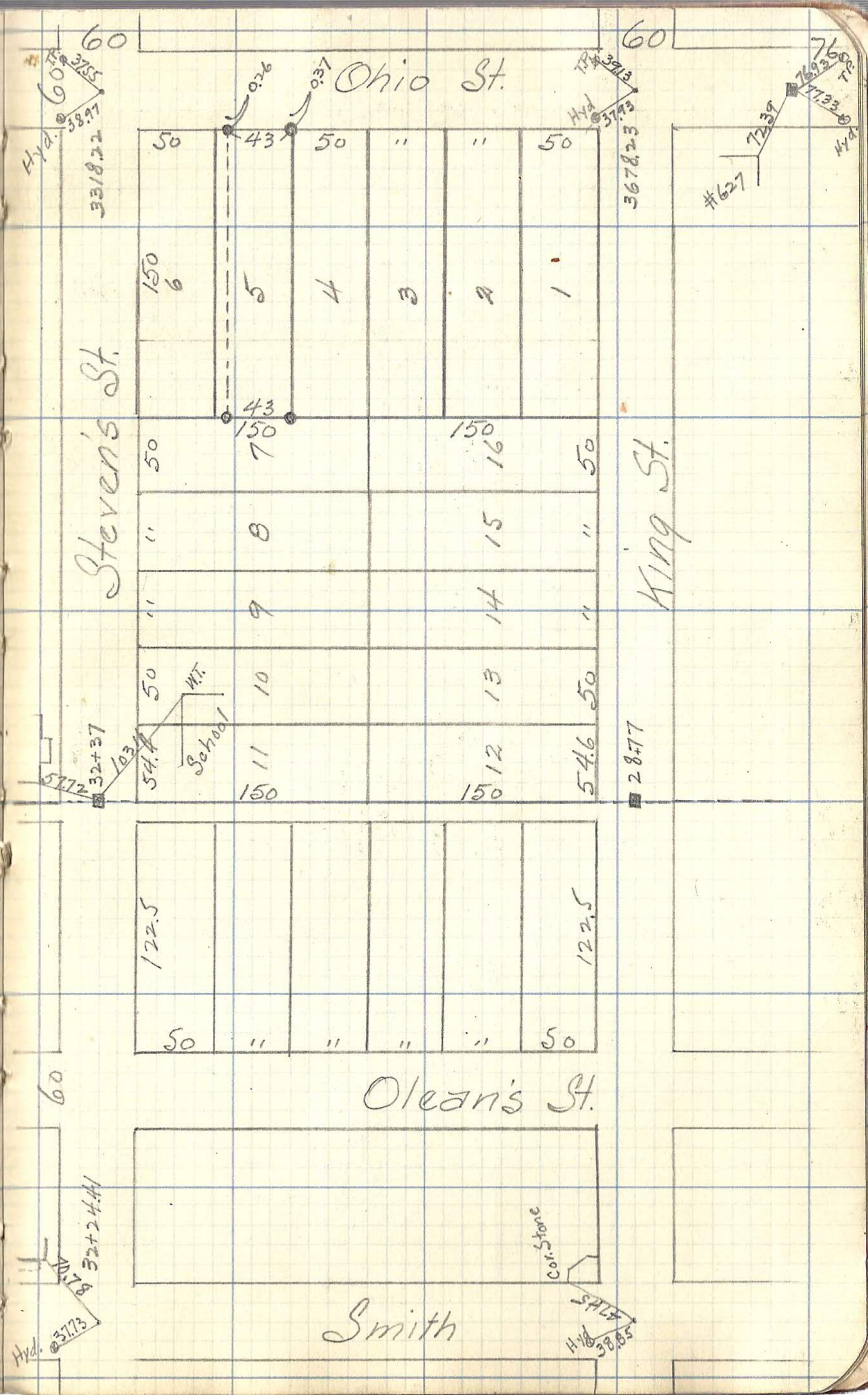
Ohio St.
Stevens St.
King St.
Olean's St.
Smith
60
60
60
76
0.26
0.37
43
43
150
150
150
50
50
50