

EASTVILLE HEIGHTS  
LOT 3 BLK. 7

66


66

8

FOREST ST.

ROSE ST.

598.51 M.

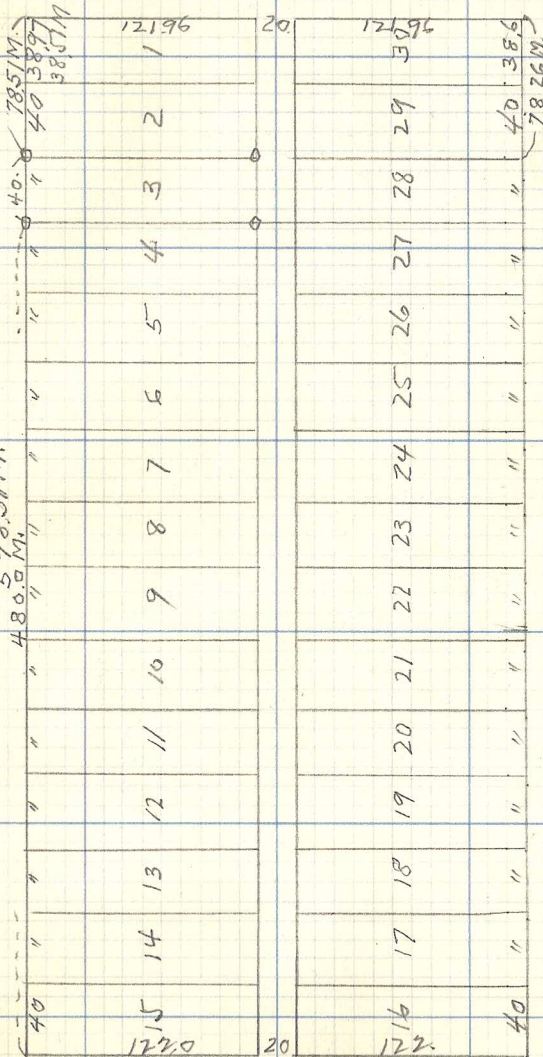

MENDOTA ST.

GERANIUM ST.