Blk's 5-6-7-8
Mounds View Park

Sec. 29-30-23
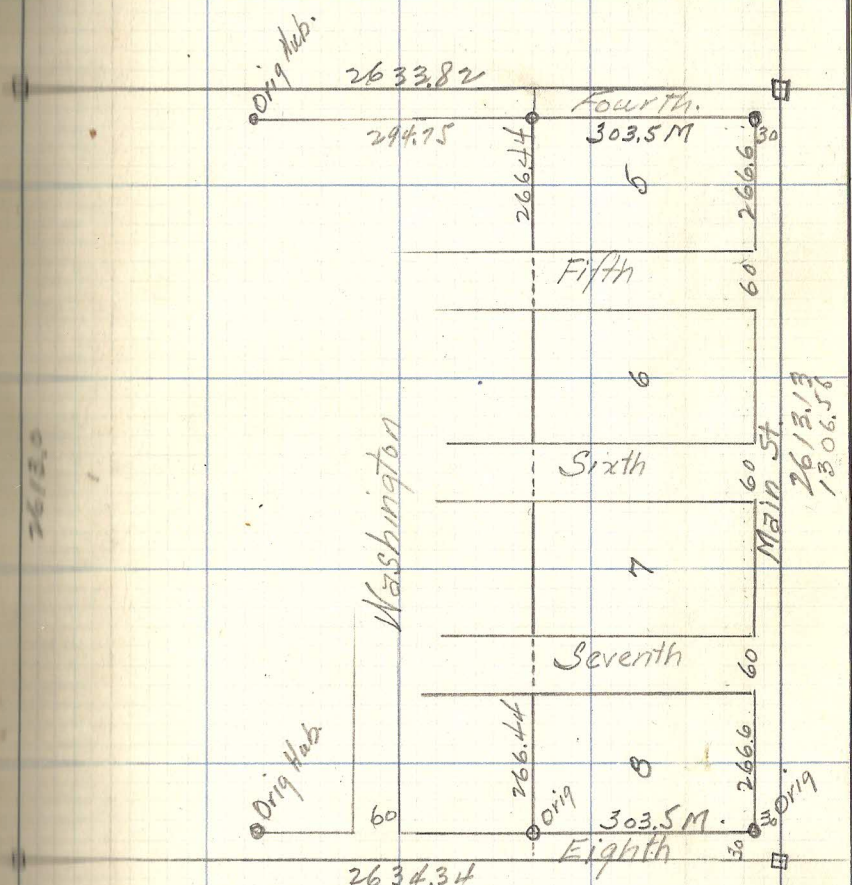
1273
50
1048.4
78
185
1361.4