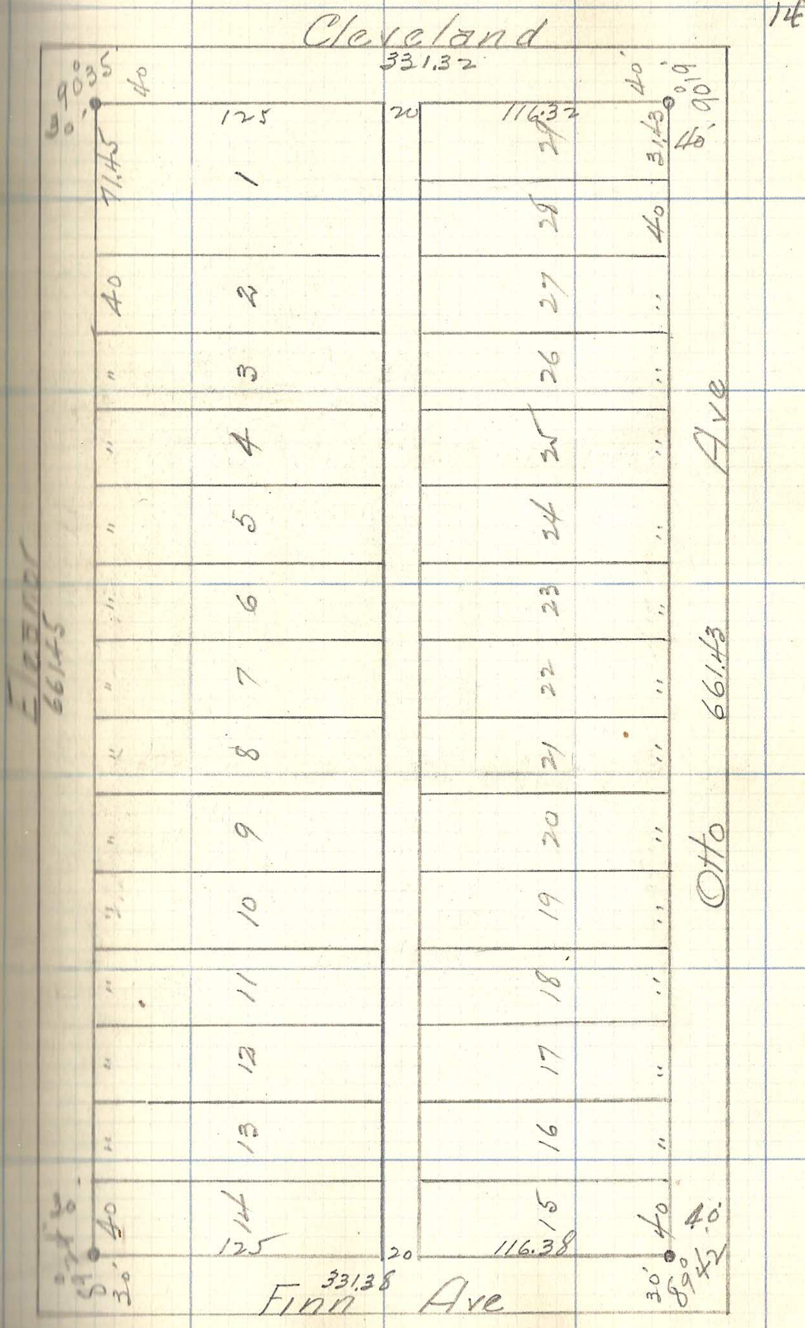John Gaarden's 3rd Add.