


Lot 7 BIK 29
Summit Park Add
July 7-26

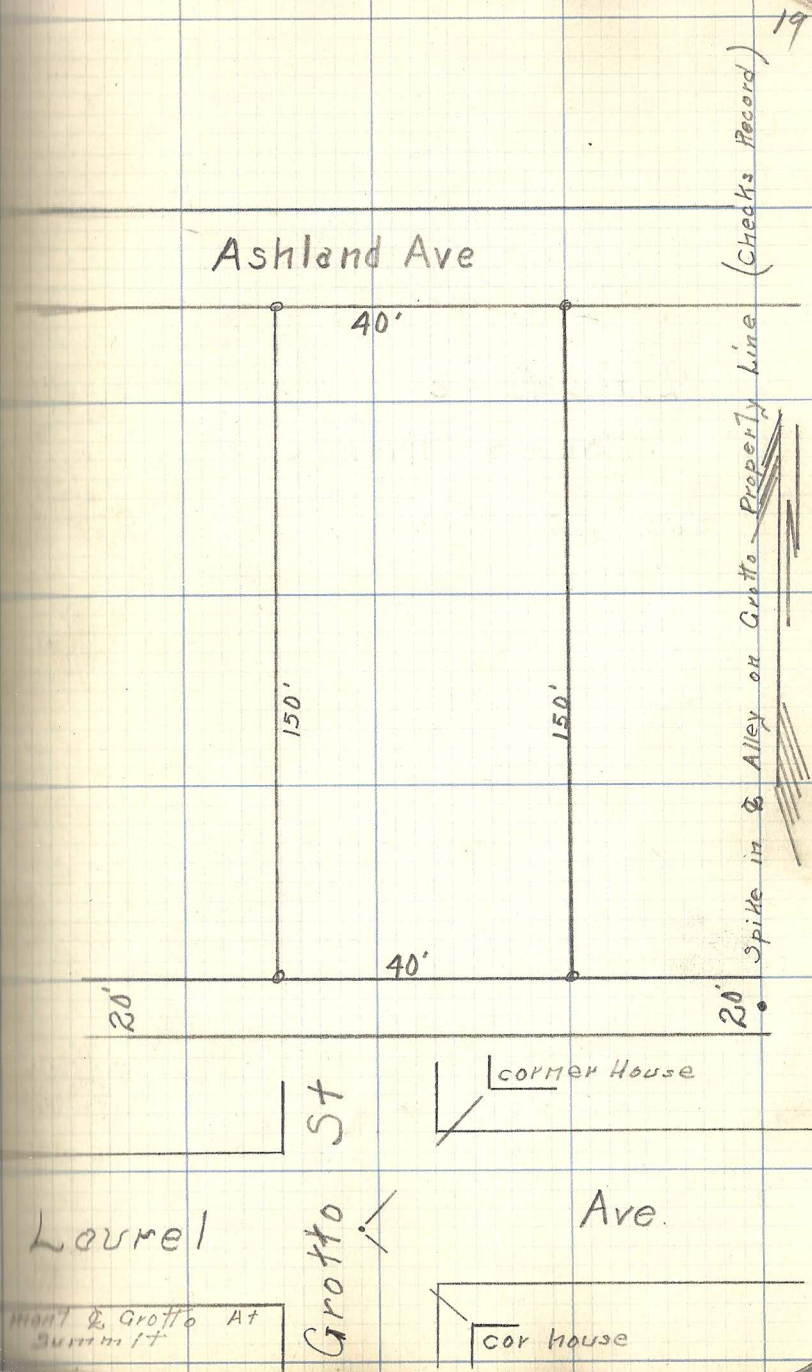

Went to Grotto At Summit