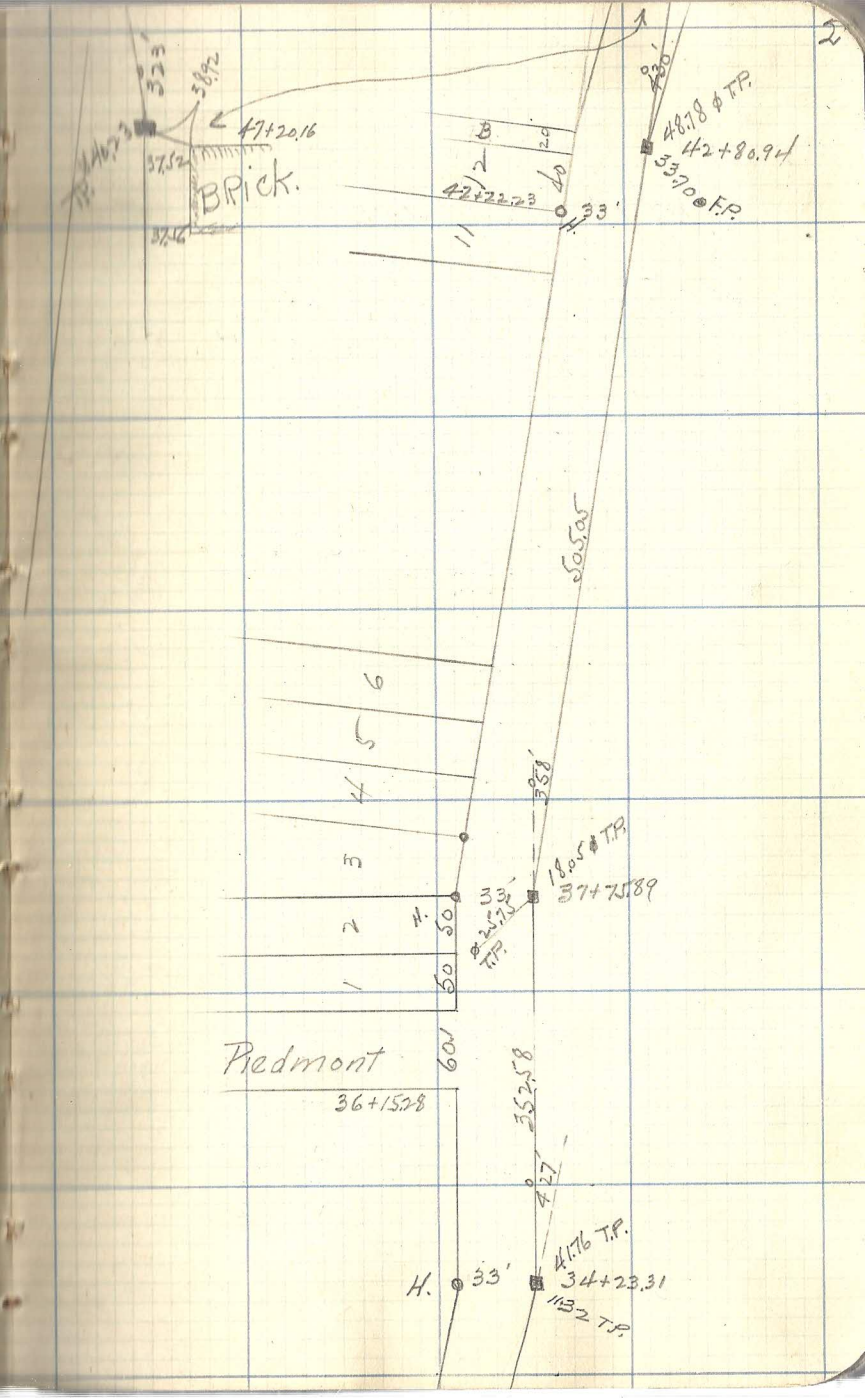2 FRont Corners
Lot 3 Blk 9
Burlington Heights Div #2
May 17-27