

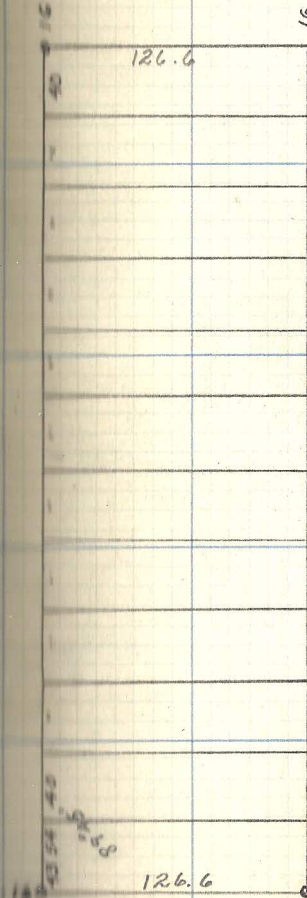
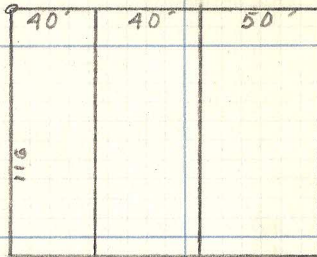


Fairview

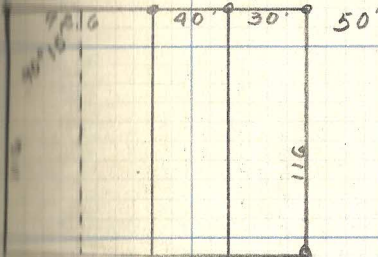

Watson Ave.

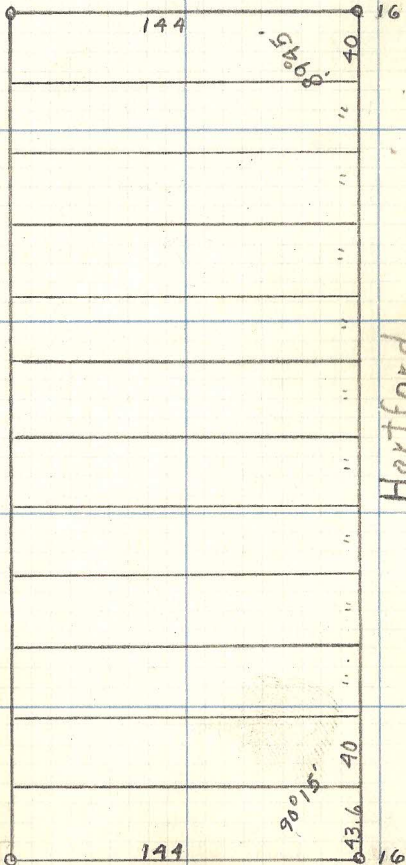

Hartford