


Lot 6 Bk 9

Owasso Add.



Mont

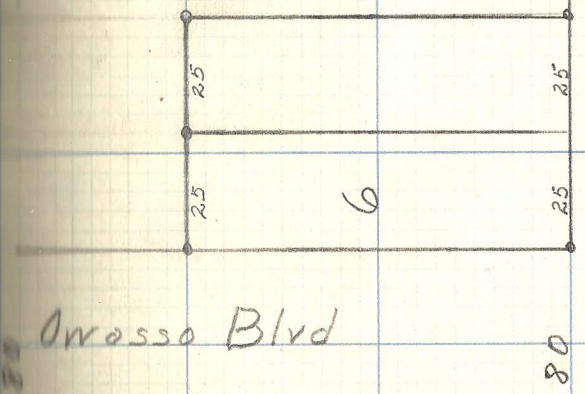

Owasso Blvd

St

Rice