

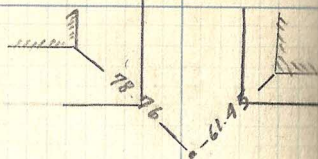


Lot-14-BIK-2  
 Palace Add.

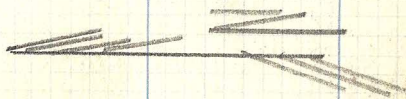

Laurel

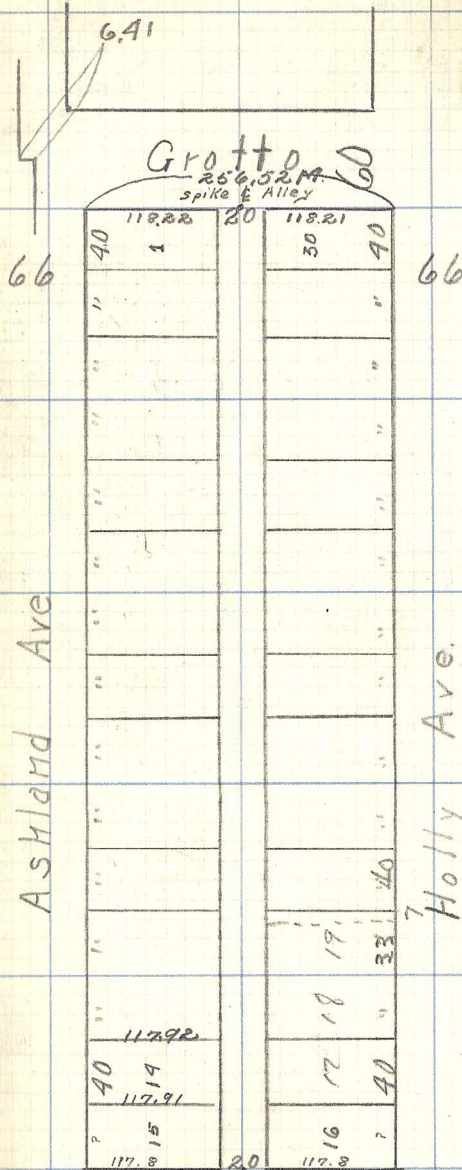

Ashland Ave

Holly Ave.

Avon

Summit Ave 23