


Lot 24
 BIK 15
 Smith's Sub.


Mont SE Cor. Charles - Mackubin

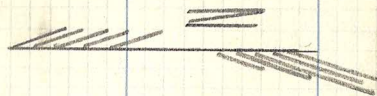

Sherburne Ave

596.03 M

317.96

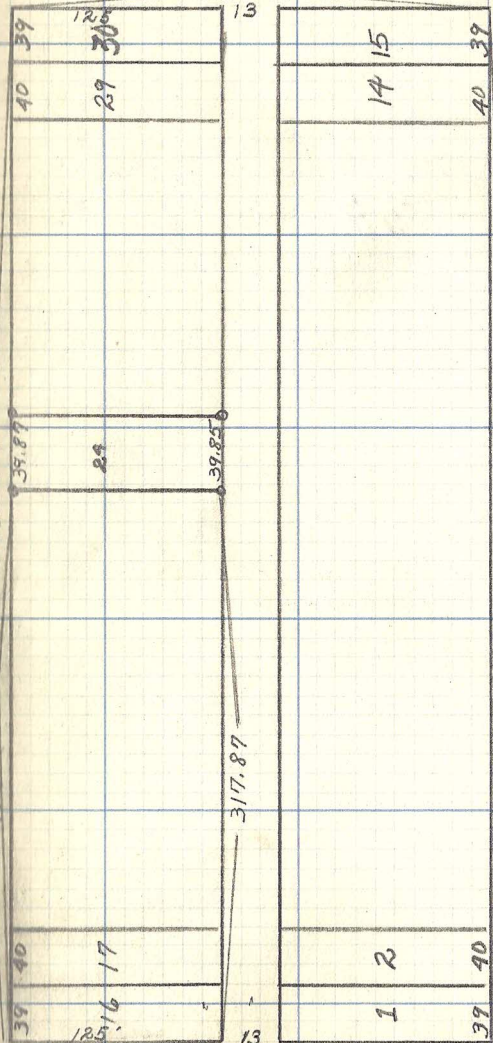

Arundel

261.60 M

13

12.8

39

40

29

30

14

15

39

40

317.87

13

12.5

39

40

17

2

1

40

39

Mackubin

261.62 M

595.7 M

Univ Ave