


Lot 11
 BIK 4
 Kuhl's Add

60

Mont NN Cor

Dayton

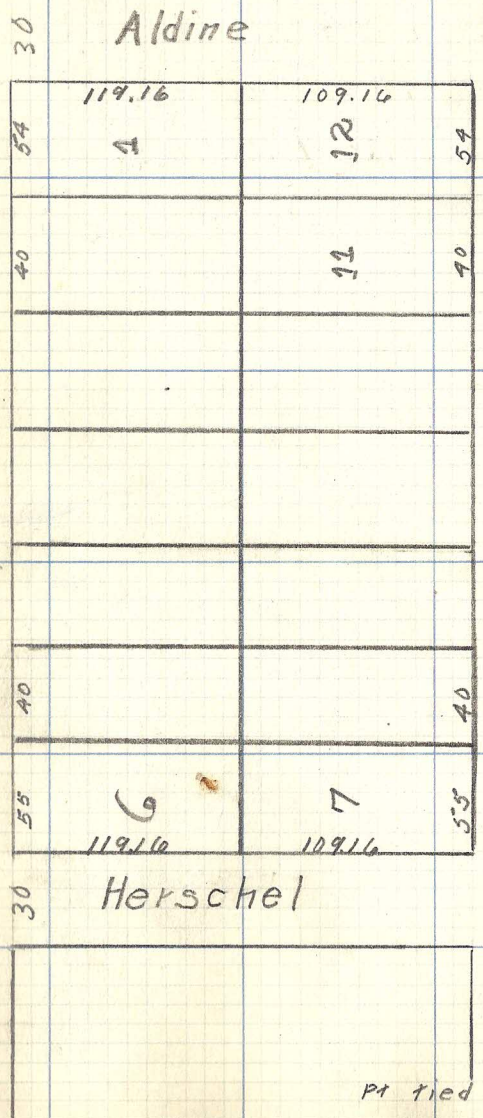

Aldine

Herschel

80

Selby

Mont N.E. Cor Hague

Pt Tied At Pierce 26

Pt Tied At Fairview