

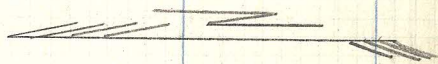


Lot 14
 BIK 5

Hamline & Syndicate
 Addition No. 2.

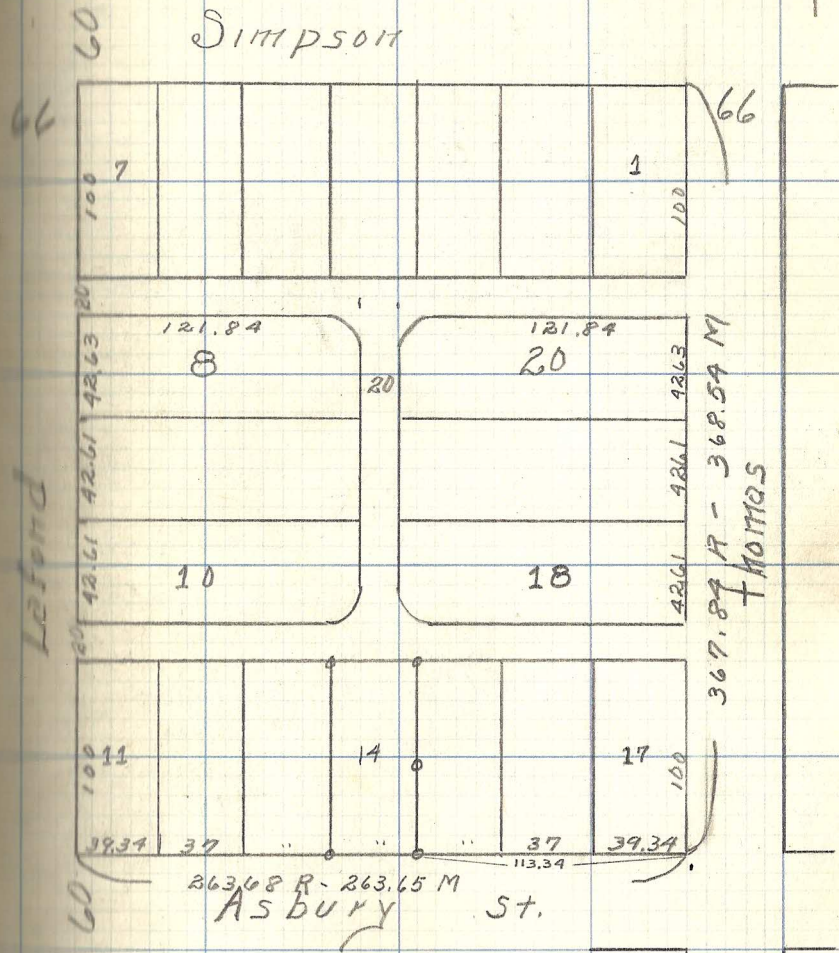

& Thomas tied At
 & Hamline

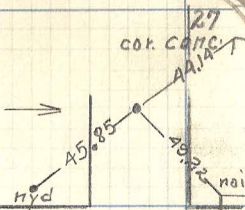

Mont At Snelling
 8.43 N. of Thomas &

